<u>CITY OF MELTON GENERAL NOTES</u>:

- SURVEY 1. ALL LEVELS ARE TO AUSTRALIAN HEIGHT DATUM AND ALL COORDINATES ARE TO MAP GRID OF AUSTRALIA (MGA) 2020, ZONE 55.
- 2. ALL EXISTING SURFACE LEVELS SHOWN ON THE ENGINEERING DRAWINGS HAVE BEEN INTERPOLATED FROM A DIGITAL TERRAIN MODEL. THESE LEVELS HAVE BEEN USED AS THE BASIS FOR ALL ENGINEERING DESIGN AND DETERMINATION OF QUANTITIES AND ARE ACCURATE TO WITHIN ±0.05m.
- ALL WORKS TO BE CARRIED OUT IN ACCORDANCE WITH AS2124–1992 GENERAL CONDITIONS OF CONTRACT, THE ROAD & DRAINAGE SPECIFICATION, APPROVED MUNICIPALITY SPECIFICATIONS AND STANDARD DRAWINGS AND TO THE SATISFACTION OF THE SUPERINTENDENT AND THE MUNICIPAL ENGINEER OR HIS REPRESENTATIVE.
- ROAD CHAINAGES REFER TO ROAD CENTRELINES. CHAINAGES FOR INTERSECTIONS AND 4. CUL-DE-SACS REFER TO THE LIP OF KERB

<u>EARTHWORKS</u>

- THE LOCATION OF EXISTING SERVICES SHOULD BE DETERMINED BY THE CONTRACTOR PRIOR TO COMMENCING ANY EXCAVATION BY CONTACTING ALL LOCAL SERVICE AUTHORITIES. ANY EXISTING SERVICES SHOWN ON THESE DRAWINGS ARE OFFERED AS A GUIDE ONLY AND ARE NOT GUARANTEED AS CORRECT.
- WHERE REQUIRED ANY BUILDINGS, TROUGHS, FENCES AND OTHER STRUCTURES ON SITE ARE TO BE REMOVED AS DIRECTED BY THE ENGINEER. THE COST OF REMOVAL IS TO BE INCLUDED IN THE OVERALL EARTHWORKS FIGURE UNLESS A SPECIFIC ITEM FOR REMOVAL IS DENOTED IN THE SCHEDULE.
- 7. ALL EXCAVATED ROCK AND SURPLUS SPOIL TO BE REMOVED AND DISPOSED OFF SITE UNLESS NOTED OTHERWISE.
- 8. ALL FILLING ON LOTS AND WITHIN ROAD RESERVES GREATER THAN 200mm IS TO BE UNDERTAKEN USING LEVEL 1 SUPERVISION AND BE COMPLETED IN ACCORDANCE WITH AS 3798–2007. FILL AREAS ARE TO BE STRIPPED OF TOPSOIL, FILLED AND REPLACED WITH TOPSOIL (WHERE REQUIRED) TO OBTAIN THE FINAL LEVELS SHOWN ON THE DRAWINGS.
- 9. FILLING MATERIAL IS TO BE IN ACCORDANCE WITH THE SPECIFICATION, AS 3798-2007 & TO THE SATISFACTION OF COUNCIL AND THE SUPERINTENDENT.
- 10. ALL BATTERS SHALL BE 1 IN 6, UNLESS OTHERWISE SHOWN.
- 11. NO FILL OR STOCKPILING OF MATERIAL IS TO BE PLACED ON ANY RESERVE FOR PUBLIC OPEN SPACE UNLESS OTHERWISE DIRECTED OR APPROVED BY THE SUPERINTENDENT.
- 12. TBM'S TO BE RE-ESTABLISHED BY THE LICENSED SURVEYOR IF FOUND TO BE MISSING AT 33. ALL TREES AND SHRUBS ARE TO BE RETAINED UNLESS OTHERWISE SHOWN. IF ROAD AND THE COMMENCEMENT OF CONSTRUCTION. THE CONTRACTOR WILL BE RESPONSIBLE FOR CARE AND MAINTENANCE OF T.B.M.'S THEREAFTER.
- 13. AT LEAST 3 DAYS PRIOR TO COMMENCING WORK ON EXCAVATIONS IN EXCESS OF 1.50m DEEP, A NOTIFICATION FORM MUST BE SENT TO WORKSAFE. THE CONTRACTOR IS TO COMPLY WITH WORKSAFE, THE MINES (TRENCHES) REGULATION 1982, THE MINES ACT 1958 AND OCCUPATIONAL HEALTH AND SAFETY ACT 1985, 2004.
- 14. ALL SERVICE TRENCHES UNDER DRIVEWAYS, FOOTPATHS AND PARKING BAYS TO BE BACKFILLED WITH CLASS 2 CRUSHED ROCK. SERVICE TRENCHES LESS THAN 750mm BEHIND KERB AND CHANNEL OR PAVED TRAFFIC AREAS ARE ALSO TO BE BACKFILLED WITH COMPACTED CLASS 2 CRUSHED ROCK.
- 15. WHERE REQUIRED, ALL EXISTING DAMS, DEPRESSIONS AND DRAINS ARE TO BE BREACHED, DRAINED, DESLUDGED AND SHALL BE EXCAVATED TO A CLEAN FIRM BASE. THE SURFACE SHALL BE INSPECTED. APPROVED AND LEVELED BY THE ENGINEER PRIOR TO COMMENCEMENT OF FILLING. THE FILL SHALL BE APPROVED SELECTED ON SITE MATERIAL OR APPROVED IMPORTED MATERIAL. THE FILL SHALL BE PLACED UNDER CONTROLLED MOISTURE CONDITIONS IN ACCORDANCE WITH THE SPECIFICATION
- 16. NO BLASTING TO BE CARRIED OUT WITHIN THE MUNICIPALITY WITHOUT OBTAINING COUNCILS PERMISSION.

SERVICES

17. WATER CONDUITS ARE TO BE Ø50mm . CLASS 12 P.V.C. – SINGLE SERVICE Ø100mm . CLASS 12 P.V.C. – DUAL SERVICE (DRINKING AND NON DRINKING WATER)

WITH THE FOLLOWING MINIMUM COVER TO FINISHED SURFACE LEVELS: ROAD PAVEMENT – 0.80m VERGE, FOOTPATHS - 0.45m

- 18. ALL SERVICE CONDUIT TRENCHES UNDER ROAD PAVEMENTS TO BE BACKFILLED IN ACCORDANCE WITH RELEVANT MUNICIPALITY OR ROAD AUTHORITY SPECIFICATION.
- 19. WATER CONDUITS TO BE LOCATED AS SHOW, REFER TO WATER DESIGN FOR CONDUIT OFFSETS
- 20. TELSTRA ARE TO BE NOTIFIED 7 DAYS PRIOR TO PLACEMENT OF CONCRETE WORKS. STORM WATER DRAINAGE

21. AG/SUBSOIL DRAIN TO BE LAID BEHIND KERB WHERE REQUIRED IN ACCORDANCE WITH THE COUNCIL STANDARD DRAWINGS AND CONNECTED TO UNDERGROUND DRAINAGE.

22. ALL STORMWATER DRAINS ARE TO BE CLASS '2' R.C. PIPES UNLESS OTHERWISE SHOWN.

ALL PIPES UP TO AND INCLUDING 750mm DIAMETER TO BE RUBBER RING JOINTED (R.R.J.) UNLESS STATED OTHERWISE.

- 23. CENTRELINES OF ALL EASEMENT DRAINS ARE OFFSET 1.0m OR 2.2m (WHERE OUTSIDE OF SEWER) FROM THE PROPERTY LINE UNLESS SHOWN OTHERWISE.
- 24. WHERE CURVED PIPES ARE SHOWN ON THE FACE PLANS THEY ARE TO BE LAID PARALLEL TO THE BACK OF KERB, EXCEPT WHERE A RADIUS HAS BEEN SPECIFICALLY NOMINATED. CURVED PIPES ARE TO BE APPROVED BY COUNCIL AND IN ACCORDANCE WITH THE MANUFACTURERS SPECIFICATIONS.
- 25. THE CONTRACTOR MUST PROVIDE CCTV FOOTAGE OF ALL UNDERGROUND DRAINS PRIOR TO PRACTICAL COMPLETION. ANY DAMAGED PIPES MUST BE REPAIRED AND RE-INSPECTED PRIOR TO PRACTICAL COMPLETION.

<u>PAVEMENT</u>

- 26. PAVEMENT DEPTHS MAY BE MODIFIED AS DIRECTED BY THE SUPERINTENDENT. PAVEMENT TO BE BOXED OUT TO MINIMUM DEPTH DENOTED, INSPECTED AND IF SUBGRADE IS IN QUESTION, FURTHER TESTING CARRIED OUT TO DETERMINE FINAL PAVEMENT DEPTH.
- 27. WHERE PAVEMENT IS CONSTRUCTED ON FILLING, FILL MATERIAL IS TO BE APPROVED BY THE SUPERINTENDENT AND COUNCIL. FILLING TO BE CONSTRUCTED IN LAYERS 150mm THICK WITH COMPACTION ACHIEVING 95% AUSTRALIAN STANDARD DENSITY.
- 28. WHEN PAVEMENT EXCAVATION IS IN ROCK ALL LOOSE MATERIAL (INCLUDING ROCKS AND (LAY) MUST BE REMOVED. THE SUB-GRADE MUST THEN BE REGULATED WITH COUNCIL APPROVED MATERIAL.

SIGNAGE AND LINEMARKING


- 29. LINEMARKING AND SIGNAGE TO BE INSTALLED IN ACCORDANCE WITH AS 1742 SERIES UNLESS NOTED OTHERWISE. STREET SIGNS ARE TO BE INSTALLED IN ACCORDANCE WITH COUNCIL STANDARDS.
- 30. ALL TEMPORARY WARNING SIGNS USED DURING CONSTRUCTION SHALL BE SUPPLIED AND MAINTAINED IN ACCORDANCE WITH AS 1742-3.
- TACTILE GROUND SURFACE INDICATORS ARE TO BE INSTALLED IN ACCORDANCE WITH THE DISABILITY DISCRIMINATION ACT AND RELEVANT COUNCIL STANDARD DRAWINGS. ENVIRONMENTAL
- 32. CONTRACTOR TO PROVIDE AN ENVIRONMENTAL MANAGEMENT PLAN INCLUDING SILT AND SEDIMENT RUNOFF PROTECTION ETC. PRIOR TO THE COMMENCEMENT OF WORKS.
- DRAINAGE CONSTRUCTION NECESSITATES THEIR REMOVAL, WRITTEN PERMISSION MUST BE OBTAINED FROM THE SUPERINTENDENT.
- 34. TREES NOT SPECIFIED FOR REMOVAL ARE TO BE PROTECTED WITH APPROPRIATE EXCLUSION FENCING PRIOR TO COMMENCEMENT OF ANY WORKS.

WARNING

BEWARE OF UNDERGROUND/OVERHEAD SERVICES THE LOCATION OF SERVICES ARE APPROXIMATE ONLY AND THEIR EXACT POSITION SHOULD BE PROVEN ON SITE. NO GUARANTEE IS GIVEN THAT ALL EXISTING SERVICES ARE SHOWN. SPECIAL CONSIDERATION SHOULD BE GIVEN TO CONSTRUCTION PROCEDURES UNDER OVERHEAD ELECTRICITY TRANSMISSION LINES.



Е	DRAINAGE UPSIZED TO Q100	M.H	14/06/24
D	COUNCIL COMMENTS ADDRESSED	M.F	02/02/24
С	COUNCIL COMMENTS ADDRESSED	M.F	19/12/23
В	ISSUED FOR APPROVAL	M.F	10/11/23
А	ISSUED FOR TENDER	M.F.	05/05/23
Rev	Amendments	Approved	Date

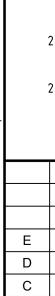

SOCIETY 1056 STAGE 1 YOURLAND



LOCALITY PLAN H 1:4000 0 40 80 SCALE @ A1

DRAWING SCHEDULE

DRAWING	DESCRIPTION	SHEET No.	REVISION	\wedge
CR100	GENERAL NOTES	1	E	
CR200	LAYOUT PLAN	2	{ E }	<u></u> Ε \
CR201	SERVICES PLAN	3	ם	
CR202	PASSIVE IRRIGATION PLAN	4	E	
CR300	ROAD LONG SECTIONS - SHEET 1	5	C	
CR301	ROAD LONG SECTIONS - SHEET 2	6	В	
CR400	ROAD CROSS SECTIONS – SHEET 1	7	В	
CR401	ROAD CROSS SECTIONS - SHEET 2	8	В	
CR402	ROAD CROSS SECTIONS - SHEET 3	9	В	
CR403	ROAD CROSS SECTIONS - SHEET 4	10	C	
CR500	INTERSECTION DETAILS – SHEET 1	11	C	\wedge
CR501	INTERSECTION DETAILS - SHEET 2	12	C }	/ E 🔪
CR502	INTERSECTION DETAILS – SHEET 3	13	D	
CR600	DRAINAGE LONG SECTIONS - SHEET 1	14	D	
CR601	DRAINAGE LONG SECTIONS - SHEET 2	15	{ D }	
CR602	DRAINAGE LONG SECTIONS – SHEET 3	16	E	
CR603	DRAINAGE LONG SECTIONS – SHEET 4	17	{ A }	
CR604	DRAINAGE LONG SECTIONS & PIT SCHEDULE - SHEET 5	18	A	
CR700	PAVEMENT AND TYPICAL DETAILS	{ 19 {	D	
CR701	PASSIVE IRRIGATION DETAILS	20	В	^
CR800	SIGNAGE AND LINEMARKING SHEET	21	D	
CR900	TEMPORARY RETARDING BASIN DETAILS	22	D	/ E \





L6 414 LA TROBE STREET PO BOX 16084 MELBOURNE VICTORIA 8007 AUSTRALIA T 61 3 9993 7888 spiire.com.au ABN 55 050 029 635

Designed **P.COLLIER** Authorised M.HOLMES



© Spiire Australia Pty Ltd All Rights Reserved This document is produced by Spiire Australia Pty Ltd solely for the benefit of and use by the client in accordance with the terms of the retainer. Spiire Australia Pty Ltd does not and shall not assume any responsibility or liability whatsoever to any third party arising out of any use or reliance by third party on the content of this document.

LEGEND


LEGEND		
DESCRIPTION	EXISTING	PROPOSED
WATER MAIN, VALVE AND HYDRANT	— — — DW — — —	DW
UNDERGROUND ELECTRICITY	-	———— E ———
OPTIC FIBRE GAS MAIN	— — — OF — — — —	OF G
SEWER & MAINTENANCE STRUCTURE	so	S
CENTRAL INVERT	> > _	>>
COUNCIL STORMWATER DRAIN AND PIT		
STORM WATER DRAINAGE PROPERTY INLETS COUNCIL STORM WATER PITS		
HOUSE DRAIN	•H	•H
AG DRAIN AND FLUSHER	———> AG ——	> AG●
STORM WATER DRAINAGE PIT NUMBER	(Ex.47)	
WATER CONDUITS	W	W
CONCRETE VEHICLE CROSSING		\searrow
HEAVY DUTY CONCRETE VEHICLE CROSSING		
SURFACE CONTOUR MINOR		
SURFACE CONTOUR MAJOR	168.90	168.90
SURFACE LEVEL	E123.45	F124.68
BATTER LEVEL (TOP / TOE) EARTHWORKS GRADE	T124.80	T124.80 1 in 150
SIGN AND POST	<u> </u>	
STREET SIGN	0	٥
PERMANENT SURVEY MARK	.	
TEMPORARY BENCH MARK		$\underline{\wedge}$
BOLLARD		
ROAD CHAINAGES	CH1 <u>16</u> .57 (L/ <u>R</u>)TP CH116.57	CH1 <u>16</u> .57 (L/ <u>R)</u> TP CH116.57
LOT CHAINAGES	CH20.06	CH20.06
SETOUT POINT		A2
LIMIT OF WORKS		
BATTER		
EXCAVATION GREATER THAN 0.20m		
EXCAVATION GREATER THAN 0.2011		
FILLING		
ROCK BEACHING		
FENCE – VEHICLE EXCLUSION		
FENCES	/ / /	/ / /
TACTILE GROUND SURFACE INDICATOR		
TREE (& SURVEYED CANOPY) TO BE RETAINED	< EJZ	
	A DA	
TREE TO BE PROTECTED		
TREE TO BE REMOVED	EX-)	
PASSIVE IRRIGATION - MODIFIED / STANDARD		sign 's
ROAD PAVEMENT		
CONCRETE PAVEMENT – FOOTPATH		
RAISED PAVEMENT		
SOCIETY	1056	
STAGE 1		
ROAD AND DI	RAINAGE TES - SHEET 1	
GENERAL NO		


MELTON CITY COUNCIL

YOURLAND


PRELIMINARY 309675-001CR100

Ε

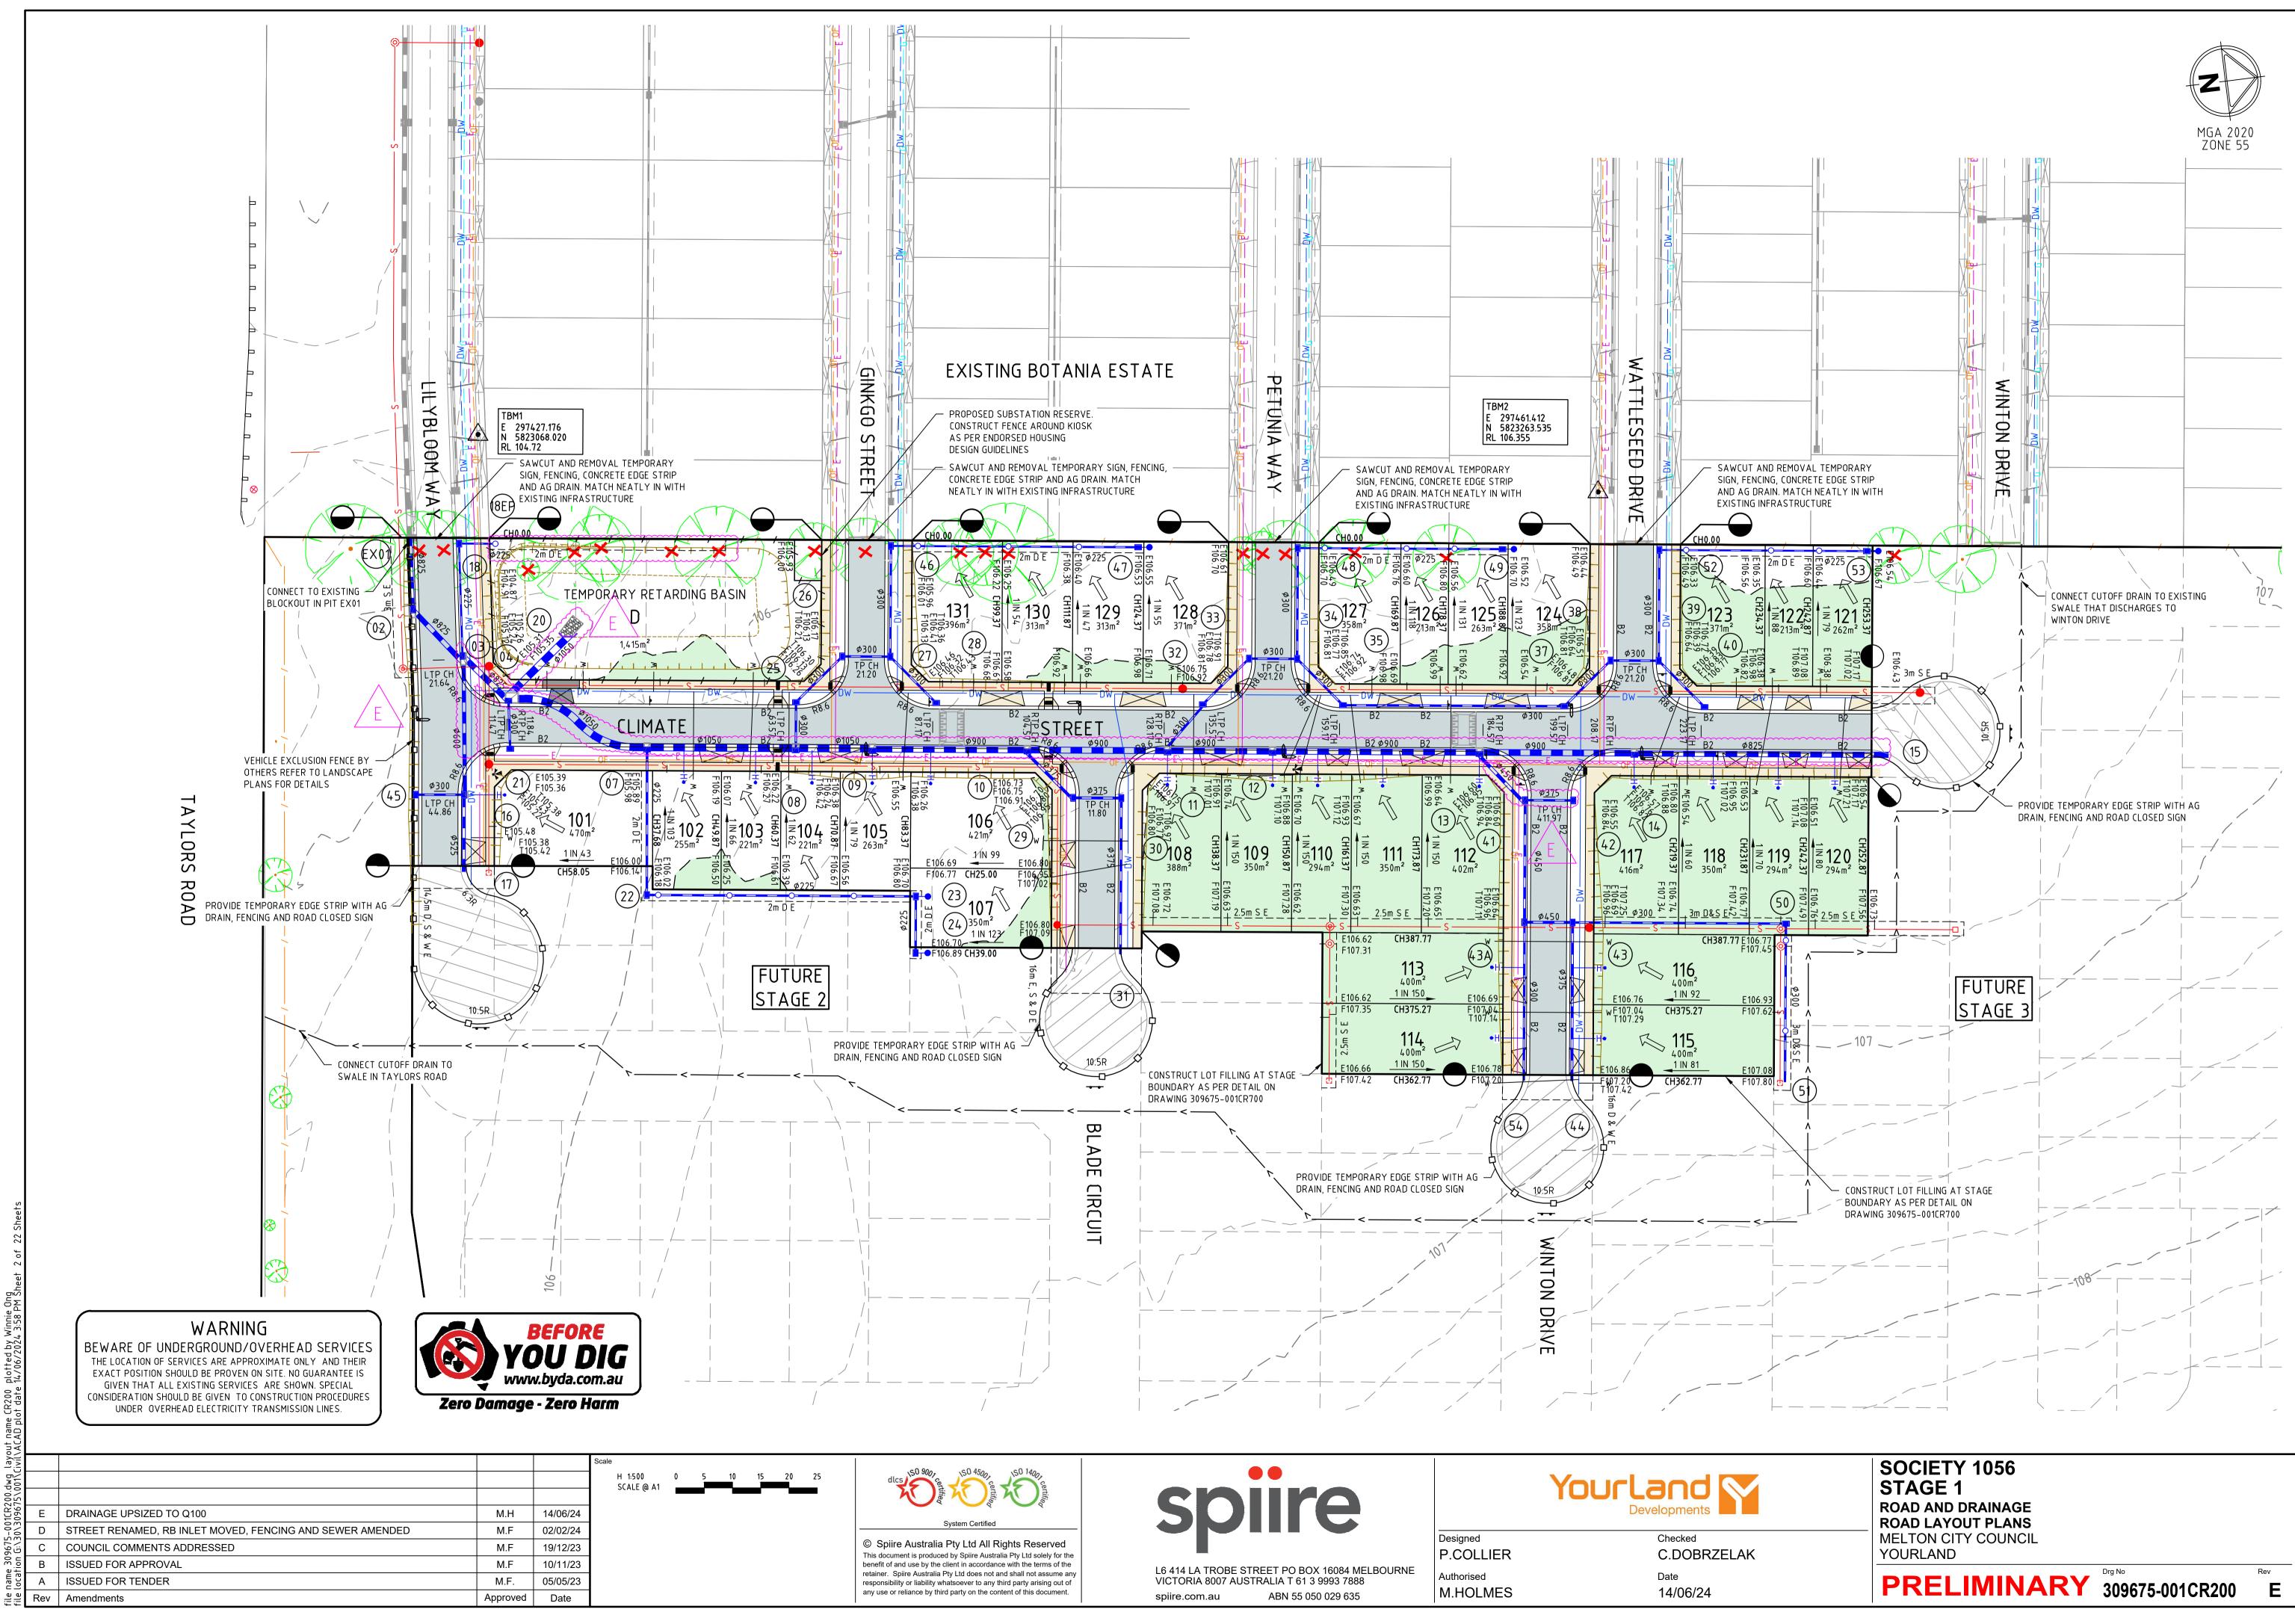

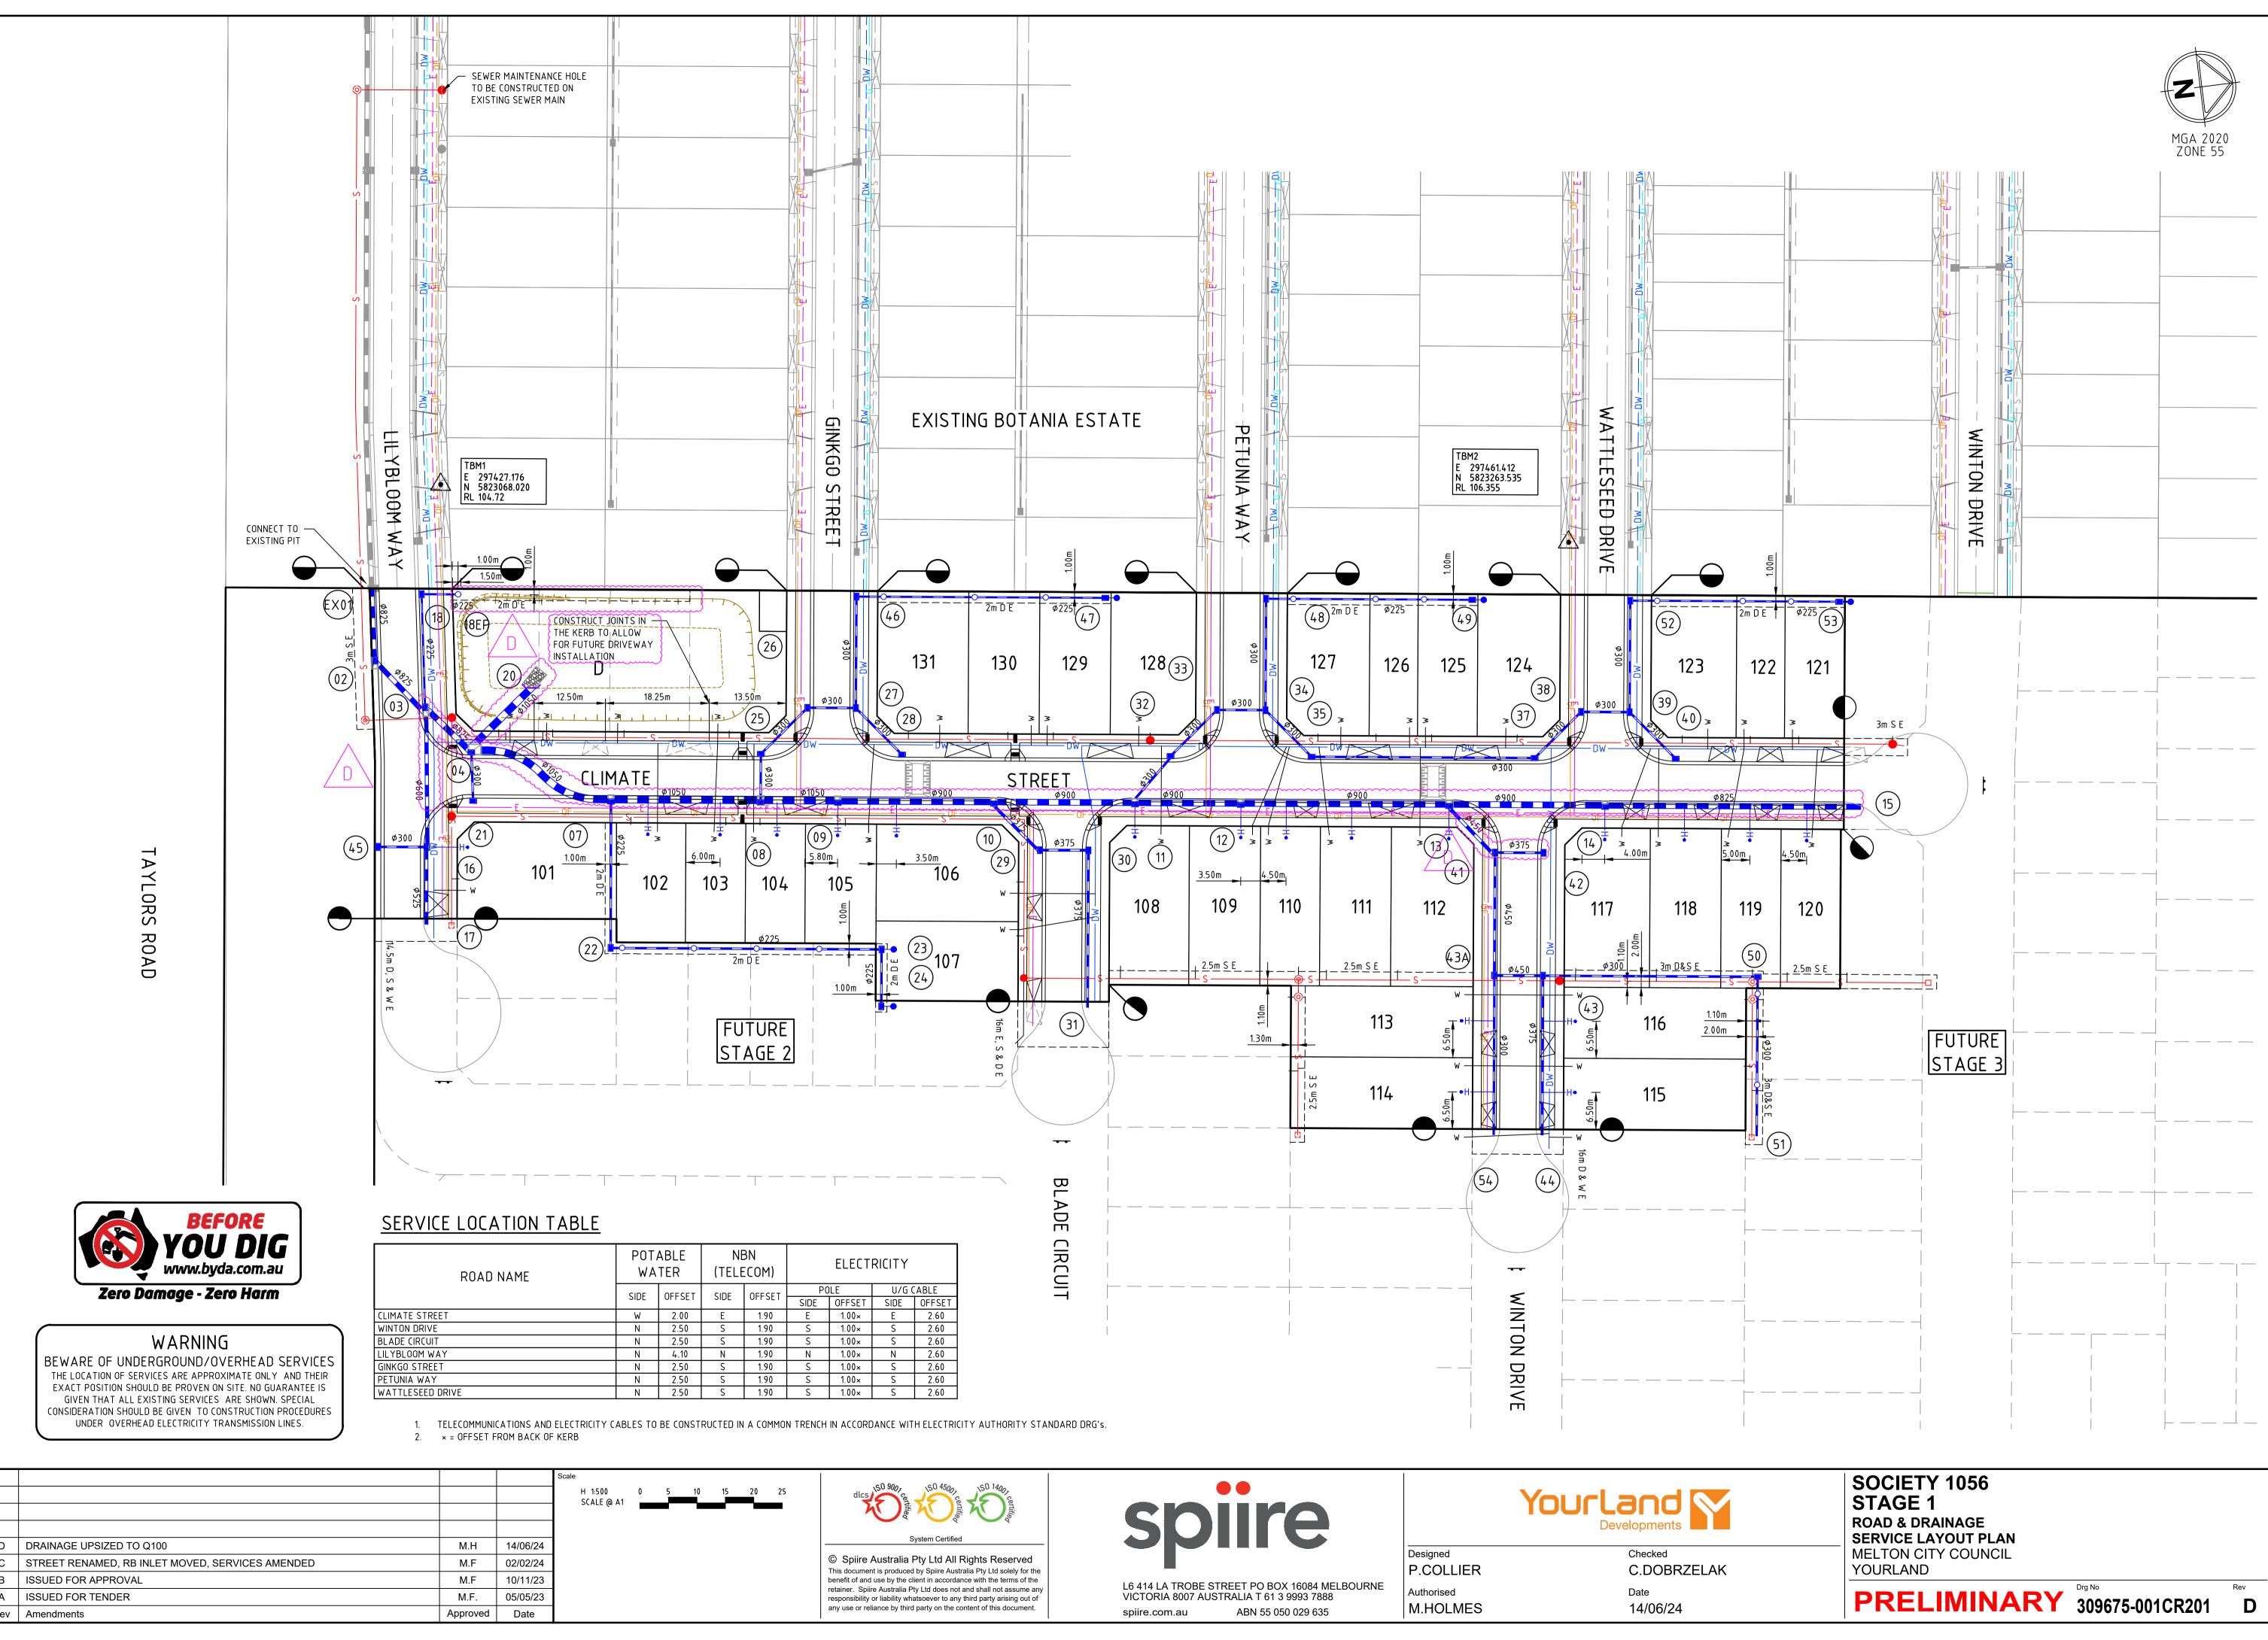

				Scale								
					H 1:500 SCALE @ A1	0	5	10	15	20	25	
D	DRAINAGE UPSIZED TO Q100	M.H	14/06/24									-
С	STREET RENAMED, RB INLET MOVED, SERVICES AMENDED	M.F	02/02/24									
В	ISSUED FOR APPROVAL	M.F	10/11/23									
А	ISSUED FOR TENDER	M.F.	05/05/23									
Rev	Amendments	Approved	Date									

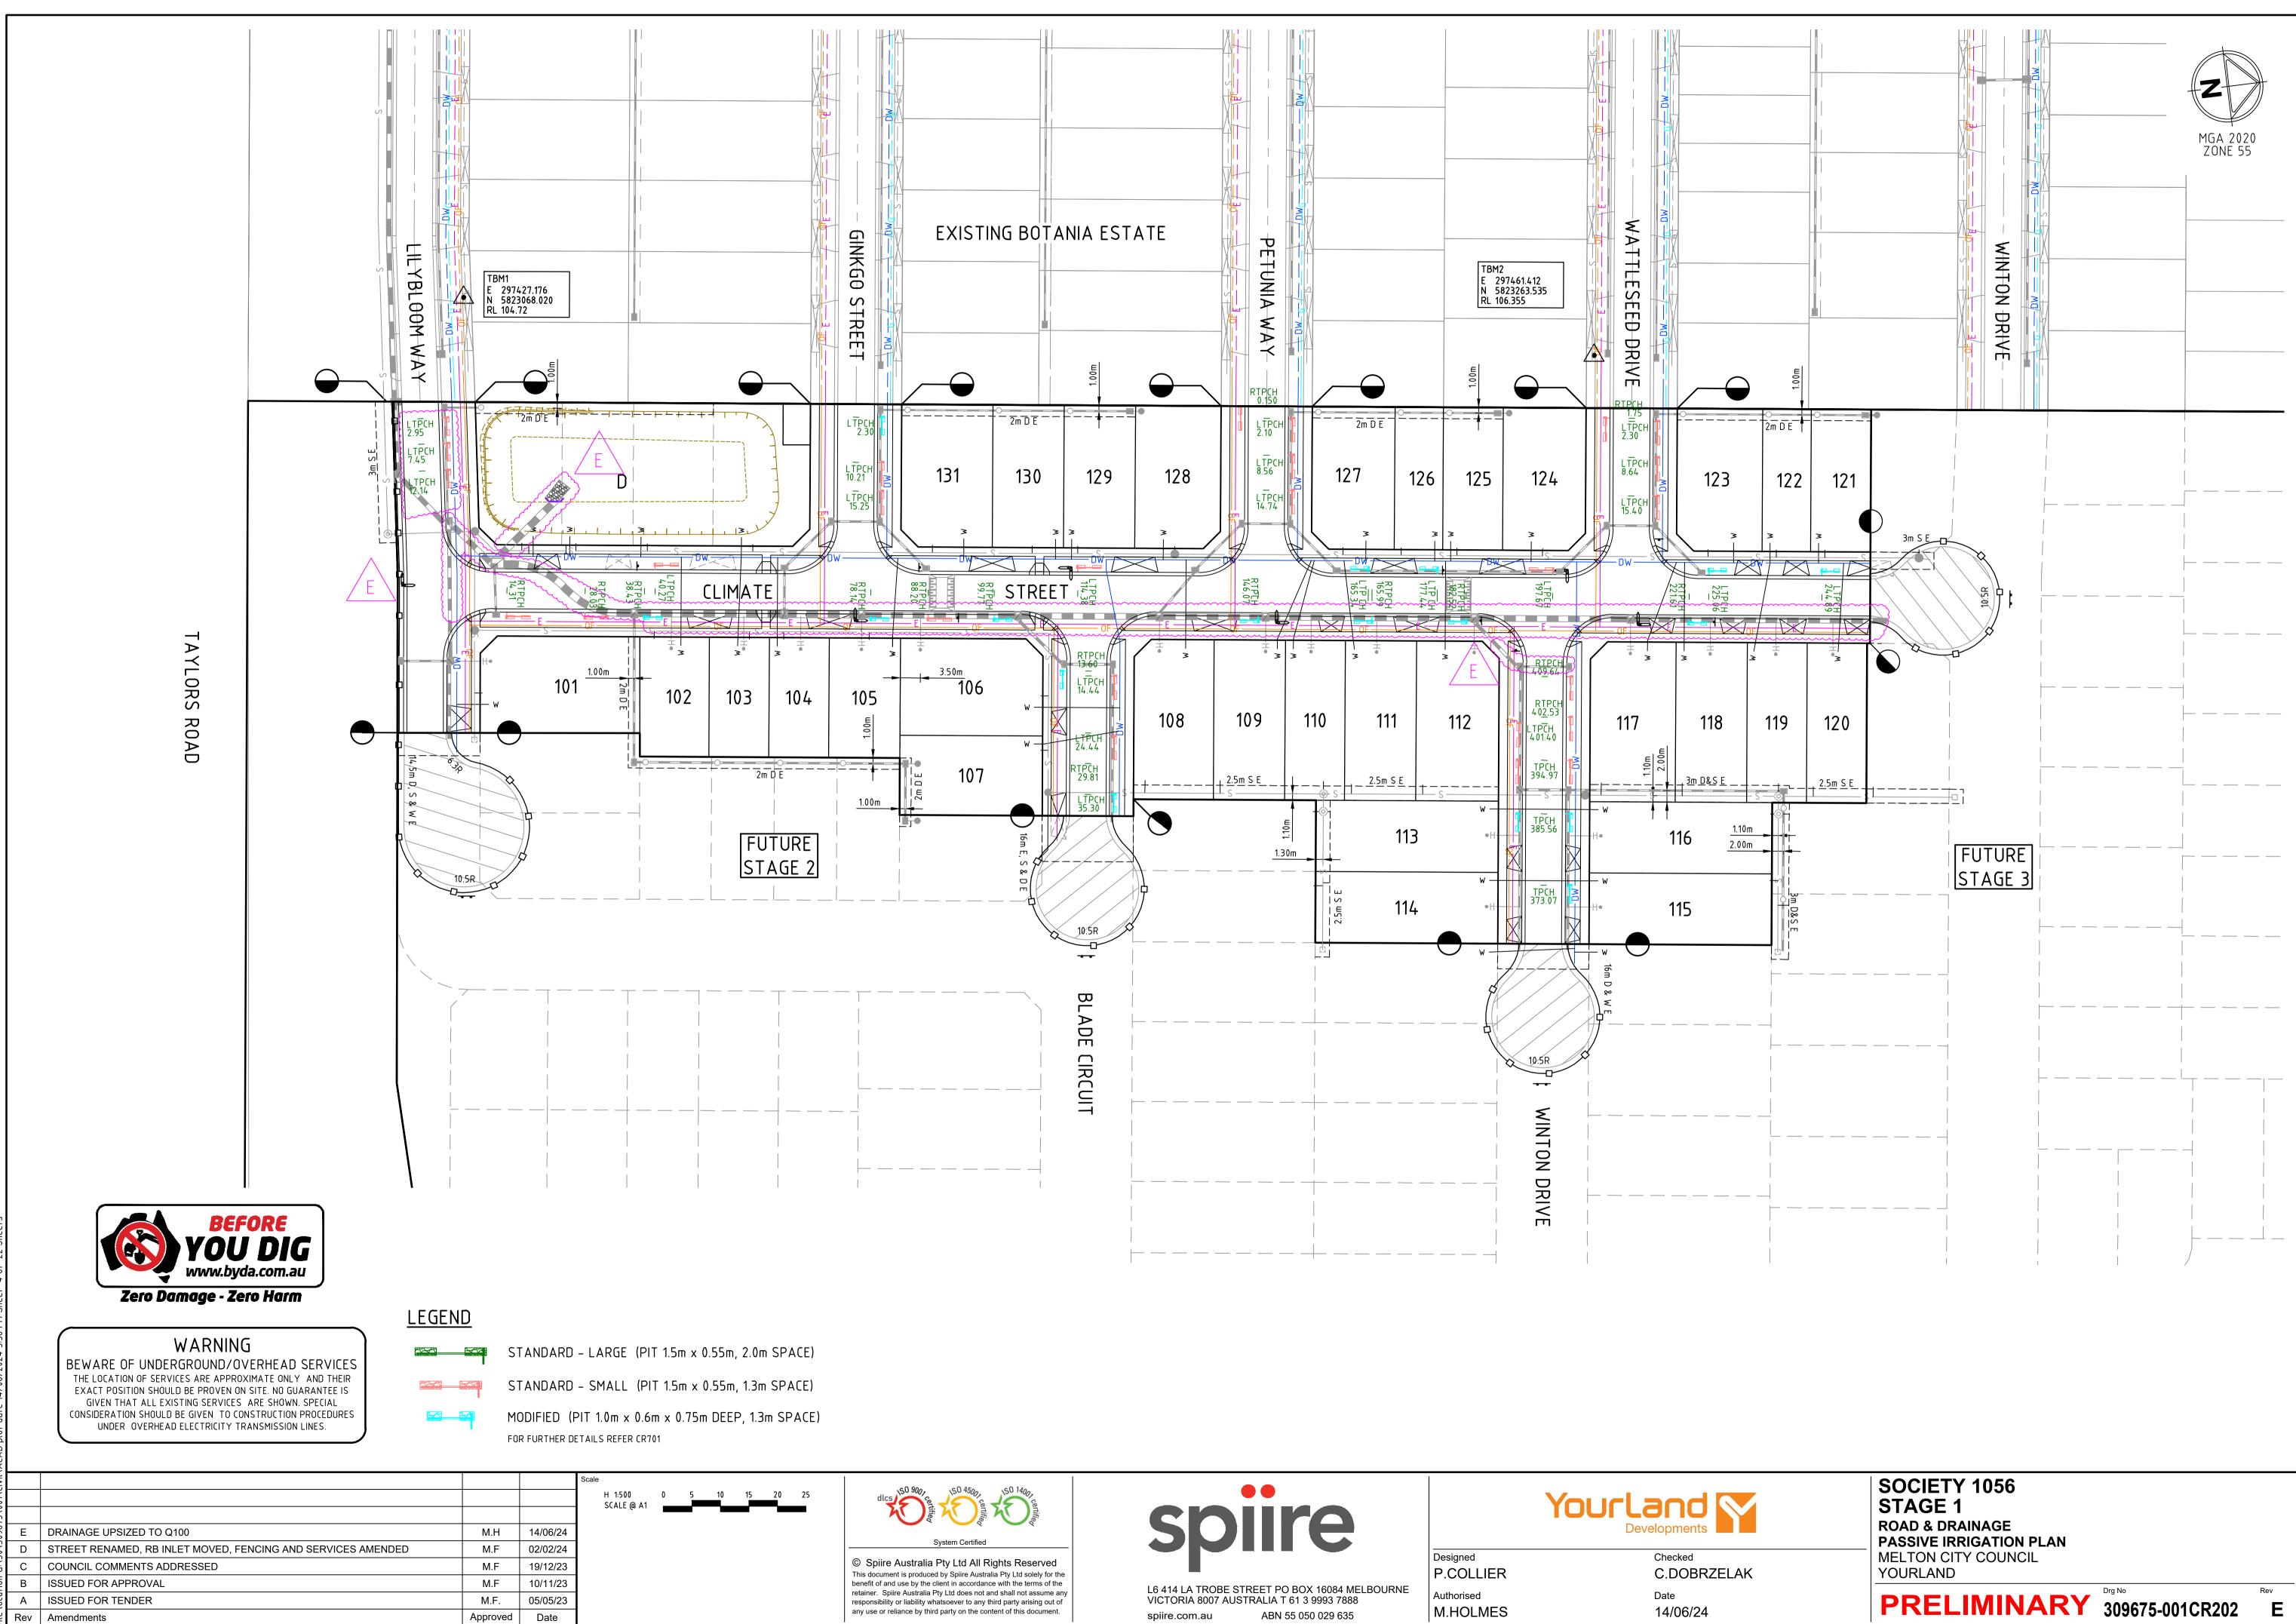

5 0	
file name 309675-001CR300.dwg layout name CR300 plotted by Winnie Ong file location G:\30\309675\001\Civil\ACAD plot date 14/06/2024 3:58 PM Sheet ¹	
ayo⊔ vil\A	
vg l 17Ci	
00.d/ 5\00	
1CR3 0967	
5-00 30\3	
967 G:\]	С
e 30 ition	В
nam loca	C B A Rev
file file	Rev

Ť

				Scale								
					1 1:500 SCALE @ A1	0	5	10	15	20	25	
					/ 1:50	0	0.5	1	1.5	2	2.5	
				1								
С	SILCRETE STREET RENAMED WINTON DRIVE	M.F	02/02/24									© This
В	ISSUED FOR APPROVAL	M.F	10/11/23									ben
Ą	ISSUED FOR TENDER	M.F.	05/05/23									reta resp
ev	Amendments	Approved	Date									any

WINTON DRIVE

 $^{\prime}$ C

		FUTURE STAGE					STAGE	
					INTERSECTION OF CLIMATE STREET. REFER TO INTERSECTION PLANS			
VERTICAL GEOMETRY			15.00m VC			VERTICAL GEOMETRY		
DESIGN GRADELINE		-1.58%		-0.50%		DESIGN GRADELINE	- 1.03%	0.50%
DATUM RL 102.5					_	DATUM RL 102.5		
DESIGN CENTRELINE		107.521 107.439 107.300	107.123 107.079 107.032 106.934 106.934 106.880 106.876 106.841	106.780 106.720		DESIGN CENTRELINE	106.773 106.824	106.938 106.969 106.974 107.017 107.017 107.025
LEFT DESIGN LIP OF KERB		107.415 107.332 107.194	107.016 106.972 106.926 106.829 106.808 106.773 106.773	106.67 <u>3</u> 106.613		LEFT DESIGN LIP OF KERB	106.666 106.718	106.832 106.862 106.867 106.867 106.910 106.918
RIGHT DESIGN LIP OF KERB	107.162 107.668 107.648 107.636	107.415 107.332 107.194	107.016 106.972 106.926 106.829 106.808 106.773 106.773	106.673		RIGHT DESIGN LIP OF KERB	106.666 106.718	106.832 106.862 106.867 106.910 106.918
EX SURFACE LEFT BOUNDARY	107.482 107.369 107.346 107.331	107.094 107.013 106.887	106.790 106.775 106.759 106.704 106.688 106.688 106.653 106.653	106.628		EX SURFACE LEFT BOUNDARY	106.763	106.720 106.705 106.700 106.680 106.680
EX SURFACE RIGHT BOUNDARY	107.634 107.541 107.522 107.510	107.206 107.206 107.025	106.882 106.857 106.857 106.830 106.775 106.761 106.728 106.688	106.634		EX SURFACE RIGHT BOUNDARY	106.774	106.803 106.803 106.803 106.803 106.751 106.740
CHAINAGE	312.766 318.766 320.000 320.766	334.766 34.0.000 34.8.766	360.000 362.766 365.731 365.731 375.266 380.000 380.731 387.766	400.000		CHAINAGE	20.000 25.000	36.000 39.000 4.0.000 4.8.500 50.200

CLIMATE STREET

						STRE	ECTION OF GINI EET. REFER TO SECTION PLAN	0				ON OF BLADI			OF PETU	NTERSECTION JNIA WAY. RE RSECTION PL/	EFER TO				ITERSECTION REFER TO INT	REFE	ER TO INT	F WATTLES		-	ST	AGE 1 JO
INTERSECTION OF LILYBLOOM WAY. REFER TO INTERSECTION PLANS																						·						
VERTICAL GEOMETRY				-	15.00m VC	->	15.00 m				- 1	 15.00m VC							IS.(00m VC 	-			 15.00m VC 				- 15.00
DESIGN GRADELINE		2.85%		1.71%		-0.50%		<	2	39%	-+		$\left \begin{array}{c} \\ \\ \\ \end{array} \right $	-0.50%).50%		╺┥╡		0.93%	-++			1.23%		
DATUM RL 103.0	$- \square$																	\downarrow				=				$ \downarrow \downarrow$		
DESIGN CENTRELINE	105.197 105.208	105.440 105.505 105.550 105.638 105.638	105.752 105.832 105.847 105.854	105.894 106.048 106.062	106.070 106.115 106.135 106.135	106.147 106.148 106.148 106.141	106.139 106.105 106.092 106.085	106.091 106.099 106.108	106.135 106.138 106.202 106.233	cc2.001 106.491 106.506 106.615	106.718 106.781 106.813	106.842 106.860 106.861 106.861	106.856 106.859	106.857 106.838 106.801	106.787 106.778	106.742 106.759	106.801 106.805	<u>∞</u> ∞	106.859 106.870 106.872	106.872 106.870 106.870	106.865 106.861 106.838 106.838	106.799 106.699 106.695	106.651 106.627	106.622 106.621 106.621 106.621	106.673 106.673 106.677 106.677	106.823 106.823 106.854	106.923	106.952 106.959 106.989 107.034 107.043
LEFT DESIGN LIP OF KERB	105.091 105.101	105.334 105.399 105.443 105.532 105.532	105.646 105.725 105.741 105.748	105.787 105.942 105.956	105.963 106.009 106.026 106.039	106.041 106.041 106.041 106.035	106.033		106.095 106.176	106.384 106.384 106.399 106.509	106.611 106.674 106 704	106.733 106.753 106.753 106.757	106.759	106.750 106.731 106.694			106.694 106.698		106.753 106.763 106.766	106.766 106.763 106.763	106.758 106.755 106.731 106.720	106.692 106.592 106.588 106.588				106.609 106.716 106.747	106.817	106.846 106.852 106.883 106.927 106.937
	105.091 105.101	105.334 105.399 105.443 105.532 105.532	105.646 105.725 105.741 105.748	105.787 105.942 105.956	105.963 106.009 106.026 106.039	106.041 106.041 106.041 106.035	106.033 105.998 105.979 105.979	105.984 105.993 106.004	106.029 106.031 106.095 106.126	106.384 106.399 106.509					106.680 106.672	106.635 106.653	106.694 106.698	106.705 106.748	106.753 106.763 106.766	106.766 106.763 106.763	106.758 106.755 106.731		106.521	106.516 106.514 106.517 106.523	106.567 106.567 106.570	106.609 106.716 106.747	106.817	106.846 106.852 106.883 106.927 106.937
EX SURFACE LEFT BOUNDARY		105.400 105.447 105.479 105.550 105.589	105.592 105.664 105.686 105.696	105.736 105.887 105.912	105.926 105.983 106.000 106.076	106.053 106.153 106.115				106.581 106.581 106.571 106.565		106.691 106.687 106.691	106.700 106.706	106.705 106.693 106.740			106.736 106.735	106.740 106.691	106.688 106.659 106.631	106.627 106.619 106.619	106.627 106.630 106.582 106.582	106.542 106.504 106.504				106.388 106.377 106.379		106.379 106.383 106.401 106.418 106.429
EX SURFACE RIGHT BOUNDARY		105.520 105.558 105.599 105.682 105.733				106.222 106.222 106.225 106.226		106.495 106.511 106.522			1 1 1			783 728	106.741 106.745	106.714 106.703	106.677 106.676			106.620 106.623 106.623			1 1 1	106.556 106.557 106.555 106.555	106.543 106.540 106.539 106.539	106.529 106.529 106.514	106.508	106.509 106.511 106.540 106.546 106.543
CHAINAGE	11.474 11.842	20.000 22.282 23.869 27.280 29.782		40.000 49.025 49.869	50.369 54.020 56.525 59.020	60.000 60.369 60.632 63.572	64.025 70.869 73.552 76.151	78.550 80.000 81.052	83.369 83.550 87.172 88 557	99.369 100.000 104.572	108.872 111.869 113 870	116.372 116.372 118.870 170 000	121.273 123.872	124.369 128.172 135.572	138.369	14.7.372 150.869	159.172 160.000				180.000 180.870 184.572 185.872	188.869 188.869 199.572 200.000			219.369 219.369 219.732 220.000		240.000	242.369 242.872 245.372 245.372 250.370 252.864

BLADE CIRCUIT



© Spiire Australia Pty Ltd All Rights Reserved This document is produced by Spiire Australia Pty Ltd solely for the benefit of and use by the client in accordance with the terms of the retainer. Spiire Australia Pty Ltd does not and shall not assume any responsibility or liability whatsoever to any third party arising out of any use or reliance by third party on the content of this document.

spire L6 414 LA TROBE STREET PO BOX 16084 MELBOURNE VICTORIA 8007 AUSTRALIA T 61 3 9993 7888


spiire.com.au


ABN 55 050 029 635

Designed P.COLLIER Authorised M.HOLMES



Checked C.DOBRZELAK Date 14/06/24

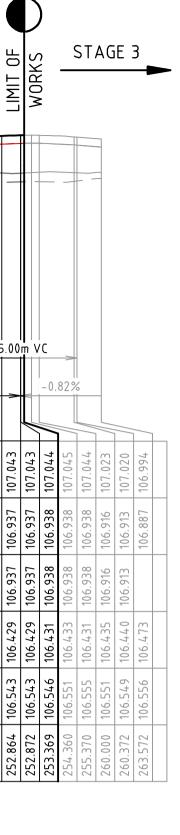

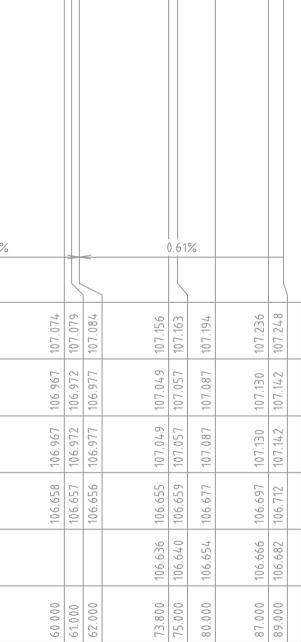



SOCIETY 1056 STAGE 1 ROAD AND DRAINAGE ROAD LONGITUDINAL SECTIONS - SHEET 1 MELTON CITY COUNCIL YOURLAND

Rev

С


רא רא												
layor ivil\/					Scale							
name 309675-001CR300.dwg l location G:\30\309675\001\Ci					H 1:500	0	5	10	15	20	25	
P.0					SCALE @ A1							
830 675					V 1:50	0	0.5	1	1.5	2	2.5	
1CF 09(
-00												-
75.												
960 D C												ד
e 3(В	ISSUED FOR APPROVAL	M.F	10/11/23								b
ame	Α	ISSUED FOR TENDER	M.F.	05/05/23								
	Davi											a
file file	Rev	Amendments	Approved	Date								

LILYBLOOM WAY


				EXISTING BOTANIA ESTATE					// WORKS	STAGE 1		(INTERSEC CLIMATE ER TO IN PLA	STREET. TERSEC)	
VERTICAL GEOMETRY DESIGN GRADELINE			0.91%			0.93%	1.33%			0.85%			0.50	%		
DATUM RL 102.0		<		>		\>	<		-	~ ~	<					>
DESIGN CENTRELINE	104.189	104.277			104.459	104.534		104.685	104.691	104.837	104.851 107.850	104.886	104.918	104.951	104.975	104.997
LEFT DESIGN LIP OF KERB									104.584	104.731	104.745 107.753				104.869	104.891
RIGHT DESIGN LIP OF KERB									104.584	104.731	104.745		104.812	104.845	104.869	104.891
EX SURFACE LEFT BOUNDARY					104.736	104.792		104.878	104.891	105.228	105.233 105.233	מרזיראו			105.398	105.428
EX SURFACE RIGHT BOUNDARY		104.309		104.440	104.487	104.473			104.822	105.023	105.018 105.018	105.016	105.043	105.099	105.134	105.168
CHAINAGE	-49.652	-40.000		-21.702	-20.000	-11.964		-0.639	0.000	17.221	20.000	26.966	33.461	40.000	44.861	49.259

PETUNIA WAY

			BOT	EXISTING ANIA ESTATE	LIMIT OF	WORKS	STAGE 1		INTERSECTION OF CLIMATE STREET. REFER TO INTERSECTION PLANS
VERTICAL GEOMETRY									
DESIGN GRADELINE		<	0.83%		>	<	0.50%		
DATUM RL 102.5								Ц	_
DESIGN CENTRELINE	106.074	106.157	106.322		106.483	106.486	106.586	106.592	
LEFT DESIGN LIP OF KERB						106.379	106.479	104.485	
RIGHT DESIGN LIP OF KERB						106.379	106.479	106.485	
EX SURFACE LEFT BOUNDARY			106.515		106.624	106.488	106.794		
EX SURFACE RIGHT BOUNDARY			106.526			106.598	106.793		
CHAINAGE	-50.000	-40.000	-20.000			0.000	20.000		

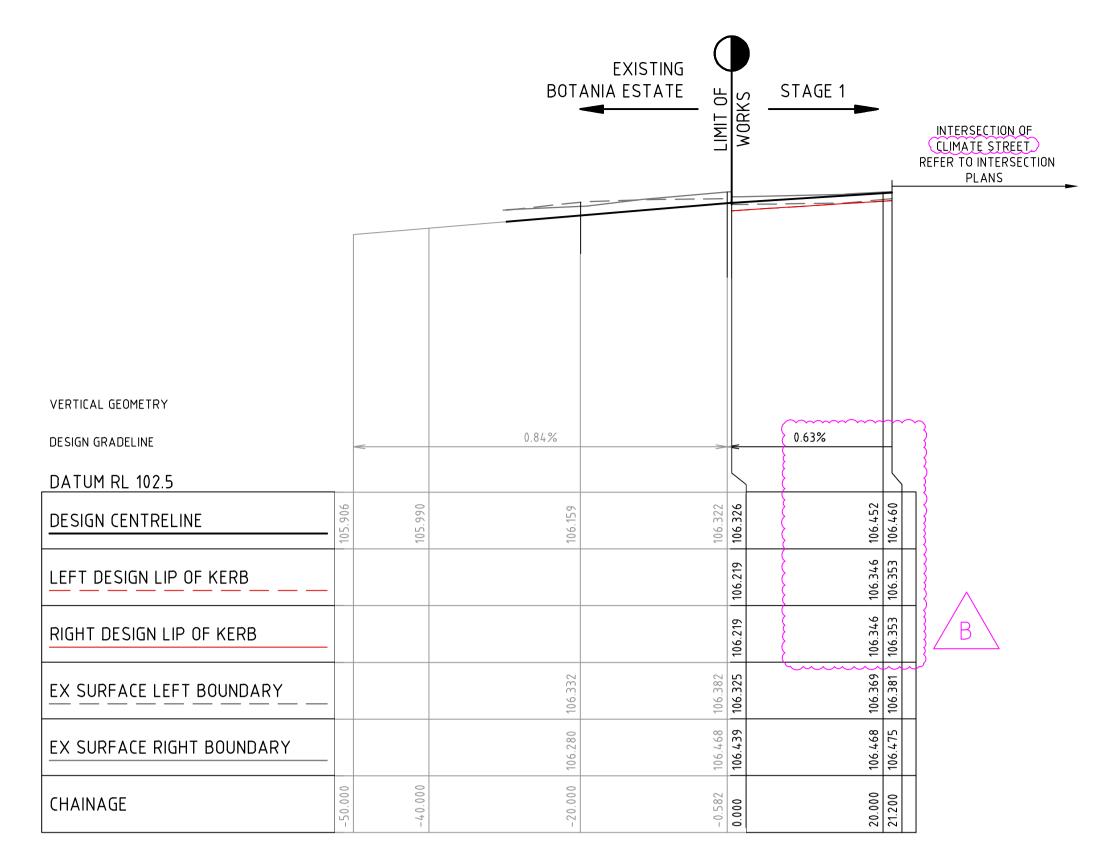

WATTLESEED DRIVE

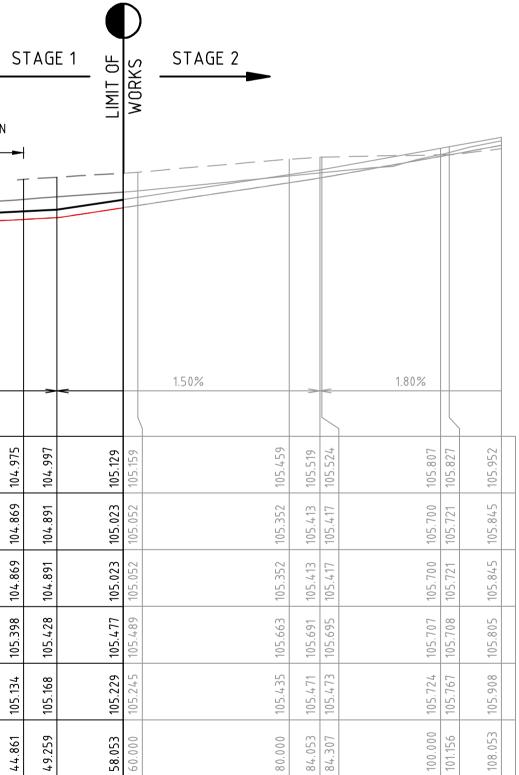

VERTICAL GEOMETRY	
DESIGN GRADELINE	
DATUM RL 102.5	1
DESIGN CENTRELINE	05.388
LEFT DESIGN LIP OF KERB	
RIGHT DESIGN LIP OF KERB	
EX SURFACE LEFT BOUNDARY	
EX SURFACE RIGHT BOUNDARY	
CHAINAGE	-50.000

GINKGO STREET



This document is produced by Spiire Australia Pty Ltd solely for the benefit of and use by the client in accordance with the terms of the retainer. Spiire Australia Pty Ltd does not and shall not assume any responsibility or liability whatsoever to any third party arising out of any use or reliance by third party on the content of this document.





L6 414 LA TROBE STREET PO BOX 16084 MELBOURNE VICTORIA 8007 AUSTRALIA T 61 3 9993 7888 spiire.com.au ABN 55 050 029 635

Designed P.COLLIER Authorised M.HOLMES



Checked C.DOBRZELAK Date 14/06/24

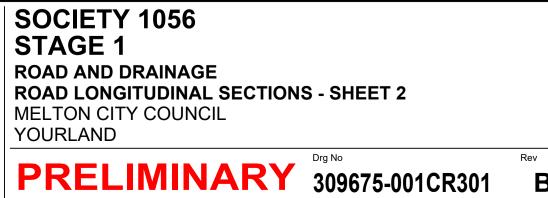

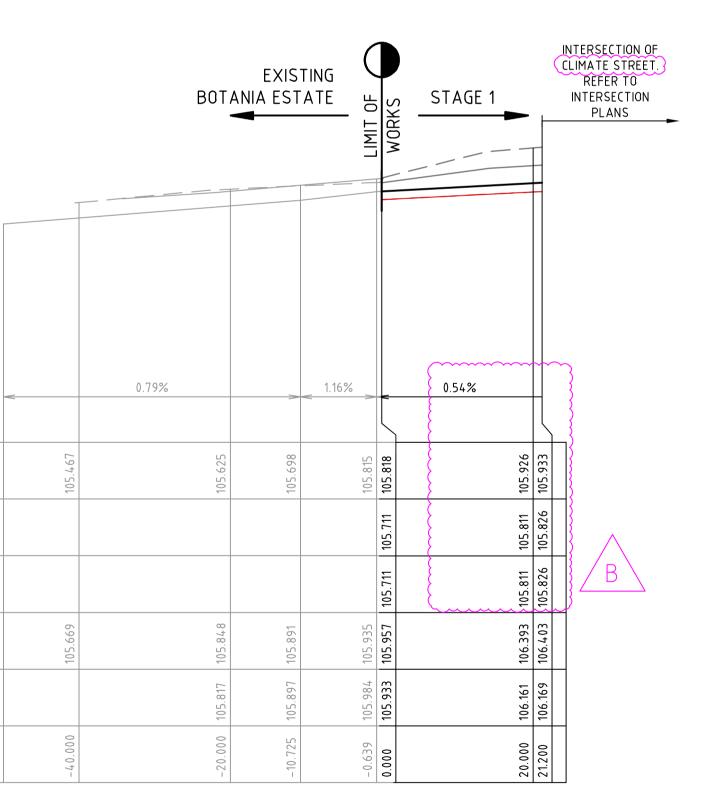

				Scale							
					0	1	2	3	4	5	
				SCALE @ A1 V 1:50	0		1	1.5	2	2.5	
					-				_		
											-
В	ISSUED FOR APPROVAL	M.F	10/11/23								
А	ISSUED FOR TENDER	M.F.	05/05/23								
Rev	Amendments	Approved	Date]							

	DATUM R.L.104.0										
	DESIGN SURFACE LEVEL	105.337	105.331	105.330	105.300	105.211	105.101	105.208	105.101	105.211	
	EXISTING SURFACE LEVEL	105.300	105.300	105.300	105.302	105.304	105.306	105.336	105.366	105.371	
\wedge	OFFSET	-8.037	-8.000	-7.950	-6.450	-3.800	-3.200	0.000	3.200	3.800	
B	CLIMATE STREET	r]						СН	11.84		

	DATUM R.L.104.0		L							
	DESIGN SURFACE LEVEL	105.978	105.976	105.946	105.858	105.748	105.854	105.748	105.858	
	EXISTING SURFACE LEVEL	105.696	105.696	105.697	105.698	105.705	105.759	105.813	105.823	
\wedge	OFFSET	-8.000	-7.950	-6.450	-3.800	-3.200	0.000	3.200	3.800	
B	CLIMATE STREET						CH 3	37.68		

F	UTURE FINISHED LOT GRADING —		1 in 5(1 in 30	Ъ -	1 in 30	1 in 30		1 in 30	1 in 50	
	DATUM R.L.104.0		\sum								
	DESIGN SURFACE LEVEL	105.978	16	105.858	105.748	105.854	105.748	105.858	105.946	105.976	105.978
	EXISTING SURFACE LEVEL	105.696	9.	160.001	105.705		105.813	105.823	105.867	105.891	105,892
										1	\square


\wedge	
B	

CLIMATE STREET

=		1 in	50	1 in 30		<u>1 in 30</u>	1in_ 30_		<u>1 in 30</u>	1 in 50			
DATUM R.L.104.0 DESIGN SURFACE LEVEL	106.294	106.263	106.233	106.145	106.035	106.141	106.035	106.145	106.233	106.263	106.265 /	106.316	
EXISTING SURFACE LEVEL		106.115 106.115		106.121	106.122	106.162	106.204	106.212	106.247	106.266	106.266	106.270	
OFFSET	-8.173	-8.000 -7.950	-6.450	-3.800	-3.200	0.000	3.200	3.800	6.450	7.950	8.000	8.309	
CLIMATE STREET						CH e	63.57						

			5 1	in 50	1 in 30		1 in 30	1 in 30		1 in 30	1 in 50	1 11	6	
DATUM R.L.105.0			K									K	1	
DESIGN SURFACE LEVEL	106.432	106.325	106.324	106.294	106.205	106.095	106.202	106 095	106.205	106.294	106.324	106.325	106.482	
EXISTING SURFACE LEVEL	106.454	106.458	106.459	106.469	106.489	106.496	106.532	106 568	106.574	106.598	106.610	106.610	106.617	
OFFSET	-8.638	-8.000	-7.950	-6.450	-3.800	-3.200	0.000	3 200	3.800	6.450	7.950	8.000	8.941	
CLIMATE STREET		~	~~	~~~~			СН	87.17				~~	~~	

FILLING NOTE ALL FILLING WITHIN ROAD RESERVES IS TO BE UNDERTAKEN USING LEVEL 1 SUPERVISION AND BE COMPLETED IN ACCORDANCE WITH AS 3798-2007 AND TO THE SATISFACTION OF COUNCIL AND THE SUPERINTENDENT. FILL AREAS ARE TO BE STRIPPED OF TOPSOIL, FILLED AND REPLACED WITH TOPSOIL (WHERE REQUIRED) TO OBTAIN THE FINAL LEVELS SHOWN ON THE DRAWINGS.

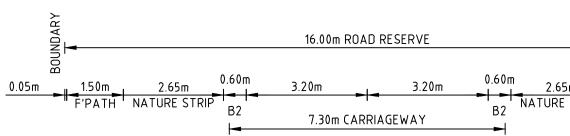

file name 309675-001CR400.dwg layout name CR400 plotted by Winnie Or file location G:\30\309675\001\Civil\ACAD plot date 14/06/2024 3:58 PM



© Spiire Australia Pty Ltd All Rights Reserved This document is produced by Spiire Australia Pty Ltd solely for the benefit of and use by the client in accordance with the terms of the retainer. Spiire Australia Pty Ltd does not and shall not assume any responsibility or liability whatsoever to any third party arising out of any use or reliance by third party on the content of this document.

L6 414 LA TROBE STREET PO BOX 16084 MELBOURNE VICTORIA 8007 AUSTRALIA T 61 3 9993 7888 ABN 55 050 029 635 spiire.com.au

spire


Designed P.COLLIER Authorised M.HOLMES Yourland Developments

Checked

14/06/24

Date

C.DOBRZELAK

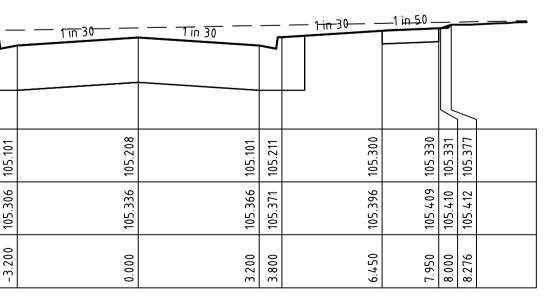

105.976 105.978

105.891 1 105.892 1

7.950 8.000

				1 in	50	1 in 30		<u> </u>	1in_30		1 in 30	1 ir
ł	DATUM R.L.105.0											
	DESIGN SURFACE LEVEL	106.777	106.738	106.737	106.707	106 619	106.509	106.615	106.509	106.619	LUC 301	100.101
	EXISTING SURFACE LEVEL	106.564	106.565	106.565	106.572	106 596	106.601	106.630	106.658	106.664	106 688	000.001
	OFFSET	-8.229	-8.000	-7.950	-6.450	008 E -	-3.200	000.0	3.200	3.800	ע איניט איניט	
	CLIMATE STREET	- }	~~	~~	~~~		<u> </u>	CH	104.57			

^	CLIMATE STREET
	(
<u> </u>	

DATUM R.L.105.0

SURFACE LEVEL

SURFACE LEVEL

CLIMATE STREET

DESIGN

EXISTING

OFFSET

_		1 in 50	1 in 30		1 in 30	1 in 30		1 in 30	1 in 50			_
DATUM R.L.105.0		5								5	<u>~</u>	
DESIGN SURFACE LEVEL	106.961	106.959 106.929	106.841	106.731	106.838	106.731	106.841	106.929	106.959	106.961	106.970	
EXISTING SURFACE LEVEL	106.693	106.693 106.693	106.693	106.698	106.725	106.753	106.758	106.776	106.783	106.783	106.783	
OFFSET	-8.000	-7.950 -6.450	- 3.800	-3.200	0000	3.200	3.800	6.450	7.950	8.000	8.052	
CLIMATE STREET			-		СН 1	28.17	-			·	~~~~~	

	<u>0.05m</u>	1.50m F'PATH	2.65m H NATURE STRI	0.60 	⊲ <u> </u>	⊲ 3.20m RIAGEWAY	0.60r B2 	™ 2.65m I NATURE STRIP	1.50m 	∞ 0.05m	
		1 in 50	1 in 30		1 in 30	1 in 30		1 in 30	1 in 50	1 in 6	
DATUM R.L.105.0	24	22		104 F	10		104	202	22	14	
SURFACE LEVEL	106.924	106.922 106.892		106.804 106.694	106.801		106.804	106.892	106.922	106.924 107.114	
EXISTING SURFACE LEVEL	106.736	106.735 106.719		106.692 106.692	106.688		106.683	106.679	106.677	106.677 106.675	
OFFSET	- 8.000	-7.950 -6.450		-3.800 -3.200	0.000		3.800	6.450	7.950	8.000	
CLIMATE STREET					CI	H 159.17					

1 in 30

1 in 30

CH 135.57

725

106

3.200 3.800

1 in 50

106.924 106.922

106.74.0 ¹

-8.000 -7.950

.450

_ __

1 in 30

90


718

106

-3.800 -3.200


16.00m ROAD RESERVE

v.oum 2.65m 1.50m 0.05m → → → → → → 2.65m → 1.50m 0.05m B2 NATURE STRIP F'PATH

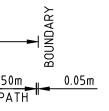

in 50			_	
106.922	106.924	107.000		
106.728 106.922	106.728	106.728 107.000		
7.950	(8.456		

1 in 30

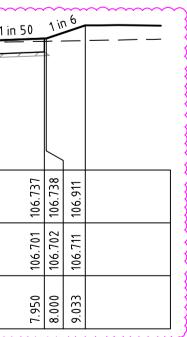




Rev

FILLING NOTE

ALL FILLING WITHIN ROAD RESERVES IS TO BE UNDERTAKEN USING LEVEL 1 SUPERVISION AND BE COMPLETED IN ACCORDANCE WITH AS 3798-2007 AND TO THE SATISFACTION OF COUNCIL AND THE SUPERINTENDENT. FILL AREAS ARE TO BE STRIPPED OF TOPSOIL, FILLED AND REPLACED WITH TOPSOIL (WHERE REQUIRED) TO OBTAIN THE FINAL LEVELS SHOWN ON THE DRAWINGS.

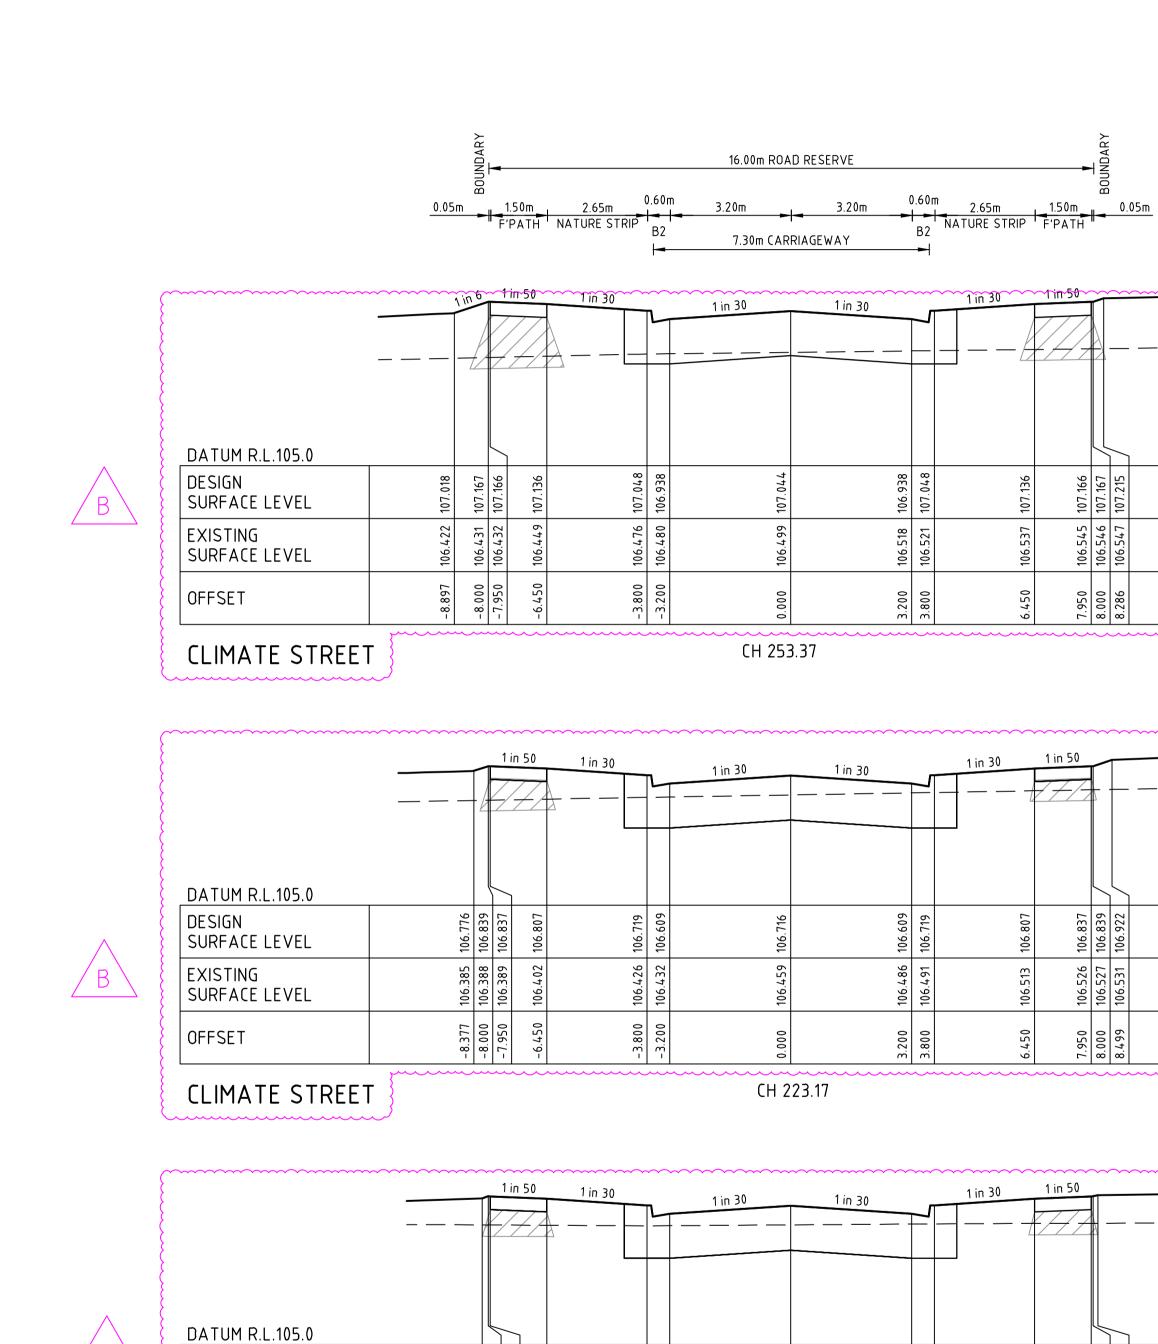



DATUM R.L.105.0									
				_					_
DESIGN SURFACE LEVEL	106.935	106.961	106.960 106.930	106.841	106.731	106.838	106.731	106.841	
EXISTING SURFACE LEVEL	106.582	106.582	106.582 106.578	106.571	106.573	106.583	106.594	106.596	
OFFSET	-8.160	-8.000	-7.950 -6.450	- 3.800	-3.200	0.000	3.200	3.800	
CLIMATE STREET						CH 18	34.57	~~~	~

				Scale							
				H 1:100 SCALE @ A ⁻	0	1	2	3	4	5	
				V 1:50	0	0.5	1	1.5	2	2.5	
											© S This d
В	ISSUED FOR APPROVAL	M.F	10/11/23	1							benefi
А	ISSUED FOR TENDER	M.F.	05/05/23	1							retaine respor
Rev	Amendments	Approved	Date								any us



106.960 106.961 106.974

106.605 106.605 106.605

7.950 8.000 8.131

6.450



L6 414 LA TROBE STREET PO BOX 16084 MELBOURNE VICTORIA 8007 AUSTRALIA T 61 3 9993 7888 spiire.com.au ABN 55 050 029 635

Designed P.COLLIER Authorised M.HOLMES



Checked

14/06/24

Date

C.DOBRZELAK

BLADE CIRCUIT

CH 11.80

		1 in 6	1 in 50	1 in 30			— <u> </u>	<u> </u>	— r	1 in 30	1 in 50	1 in	6	
						1								
DATUM R.L.105.0		Ĺ												
DESIGN SURFACE LEVEL	106.977	106.812	106.810 106.780		106.692	106.582	106.688	106.582	106.692	106.780	106.810	106.812	106.946	
EXISTING SURFACE LEVEL	106.764	106.753	106.754		106.751	106.750	106.746	106.741	106.739	106.734	106.735	106.735	106.734	
DFFSET	.8.990		-6.450		-3.800	-3.200	0.00.0	3.200	3.800	6.450	7.950	8.000	3.810	

BLADE CIRCUIT

/ B \

	1 in 50	1 in 30	1 in 30	1 in 30 	1 in 30	1 in 50	
DATUM R.L.105.0					21		
DESIGN SURFACE LEVEL	107.110 107.092 107.091 107.061	106.972 106.862	106.969	106.862	105.972	107.091 107.092	
EXISTING SURFACE LEVEL	106.704 106.705 106.705 106.716	106.728 106.730	106.747	106.774	106.791		
OFFSET	-8.107 -8.000 -7.950 -6.450	-3.800 -3.200	0.000	3.200	3.800	7.950	
BLADE CIRCUIT			CH 3	9.00			

0.60m

B2

0.05m 1.50m 2.65m 0.60m F'PATH NATURE STRIP B2

16.00m ROAD RESERVE


7.30m CARRIAGEWAY

3.20m

3.20m


[2				
107.136	107.166	107.167	107.215	
106.537 107.136	106.545	106.546 107.167	106.547 107.215	
6.450	7.950	8.000	8.286	



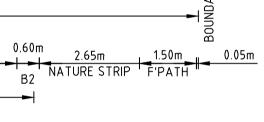




ALL FILLING WITHIN ROAD RESERVES IS TO BE UNDERTAKEN USING LEVEL 1 SUPERVISION AND BE COMPLETED IN ACCORDANCE WITH AS 3798-2007 AND TO THE SATISFACTION OF COUNCIL AND THE SUPERINTENDENT. FILL AREAS ARE TO BE STRIPPED OF TOPSOIL, FILLED AND REPLACED WITH TOPSOIL (WHERE REQUIRED) TO OBTAIN THE FINAL LEVELS SHOWN ON THE DRAWINGS.

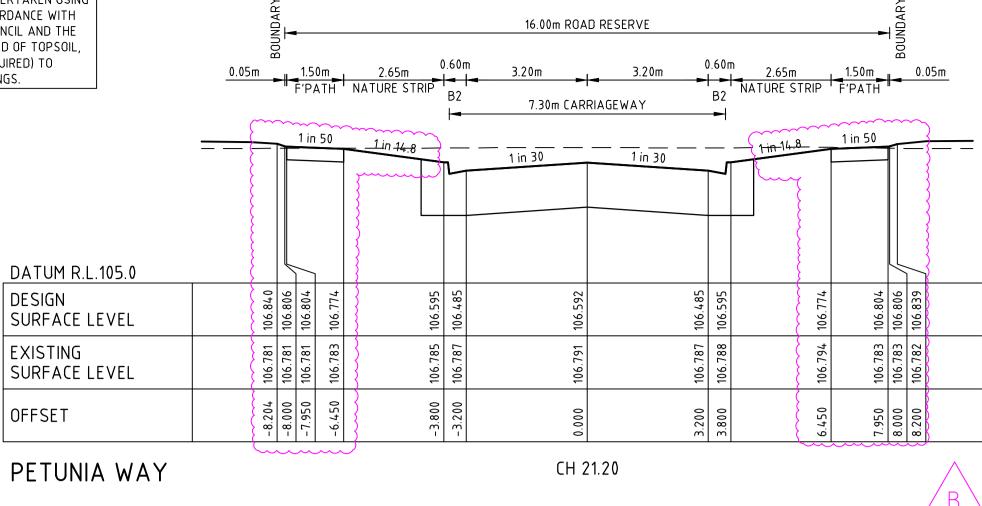

	(~~~		~~~~~	~~~~~~~~~~~~~~~~~~~~~~~~~~~~~~~~~~~~~~~
	1 in 50		<u> </u>	<u>1 in 30</u>		14.8	1 in 50 	
DATUM R.L.105.0						}	l	
DESIGN SURFACE LEVEL	106.700 106.698 106.668	106.489 106.379	106.486	106.379	106.489	106.668	106.698	106.700
EXISTING SURFACE LEVEL	106.488 106.490 106.545	106.615 106.588	106.500	106.510	106.511	106.576	106.611	106.614
OFFSET	-8.000 -7.950 -6.450	-3.800 -3.200	0.000	3.200	3.800	6.450	7.950	8.000
PETUNIA WAY	BOUNDARY		CH (16.00m RC).00 PAD RESERVE				BOUNDARY
		2.65m 0.6 NATURE STRIP B	2 <u>5.20m</u>	3.20m RRIAGEWAY	0.60m - - B2 	2.65m URE STRIP	1.50m F'PATH	0.05m
	1 in 50		<u>1 in 30</u>	1 <u>in 30</u> _		<u>1 in 20</u>	1 in 50	
DATUM R I 105 0								

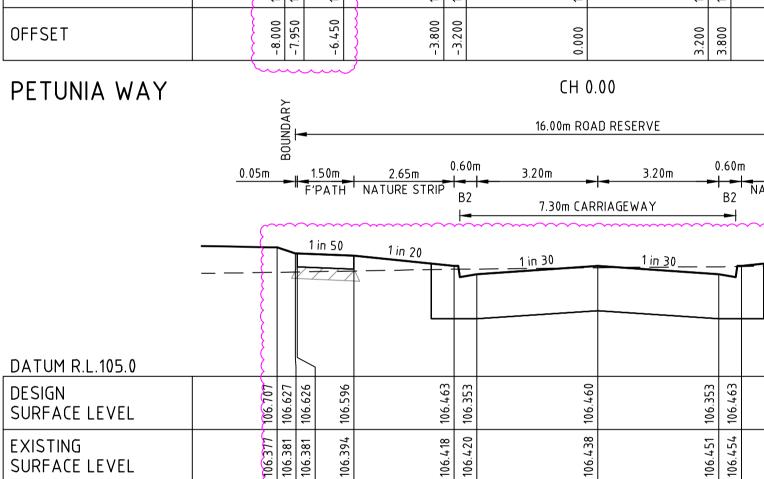


-8.477 -8.000 -7.950



OFFSET




3.200 3.800

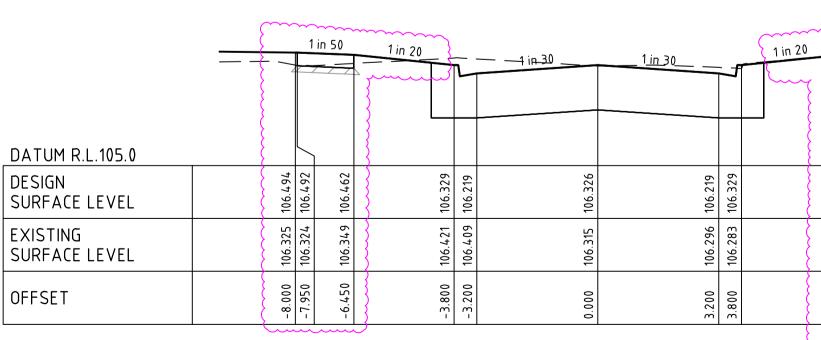

.800

WATTLESEED DRIVE

CH 0.00

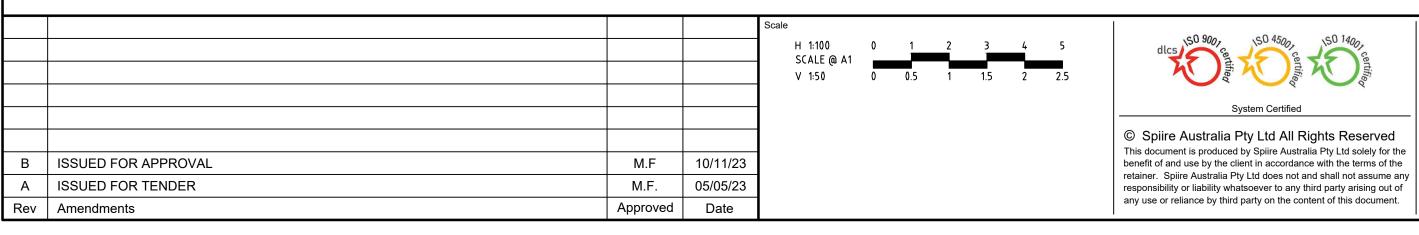



spiire.com.au

Designed P.COLLIER Authorised M.HOLMES



Date

14/06/24


C.DOBRZELAK

16.00m ROAD RESERVE


GINKGO STREET

ABN 55 050 029 635



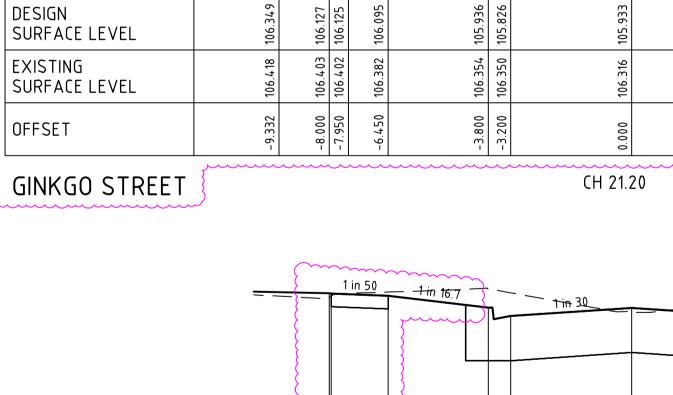

	_(.05m 🛌		1.50m PATH	2.65m NATURE STRI	0.6(3.20m	3.20m RIAGEWAY
~~~~~~~~~~~~~~~~~~~~~~~~~~~~~~~~~~~~~~~		- <u>† in</u> 6-	1	in 50	1 in 16.7	 		1 in 30	 1 in 30
DATUM R.L.104.0				ן					
DESIGN SURFACE LEVEL	106.349	106.127	106.125	106.095		105.936 105.826	070.CUI	105.933	
EXISTING SURFACE LEVEL	106.418	106.403	106.402	106.382		106.354 106.350		106.316	
	2	0	0	0		0 0	>		

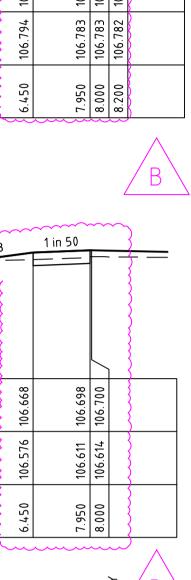

106.626 106.627 106.809

106.474 106.475 106.481

7.950 8.000 9.089

1 in 50

462

427

6.450

106.492 106.494


106.439 106.439


7.950 8.000

Β

SOCIETY 1056 STAGE 1 ROAD & DRAINAGE ROAD CROSS SECTIONS - SHEE MELTON CITY COUNCIL YOURLAND	ET 3
PRELIMINARY	Drg No 309675-001CR402

	~~~		~~~~		$\sim$	
						\wedge
						$\langle R \rangle$
				~~~~~	~~~~	$\sim$
		1 in 16.	 1	1 in 50		}
) — -	_	(1#110.			- 1	_}
		Lun	1			1
			{			{
			{			{
			}			\$
			{			}
			Ş		$\searrow$	}
1	21		80	10	12	
05.7	105.821		05.9	0.00	106.012	{
105.917 105.711	4 1		105.955 105.980	105.934 106.010	- -	$\rightarrow$
5.917	105.964		5.95!	5.93	105.933	}
10	10		10	10	10.	<u>}</u>
0	0		0	0	0	}
3.200	3.800		6.450	7.950	8.000	
	L	{	í		~	
						$\wedge$
						/ B \

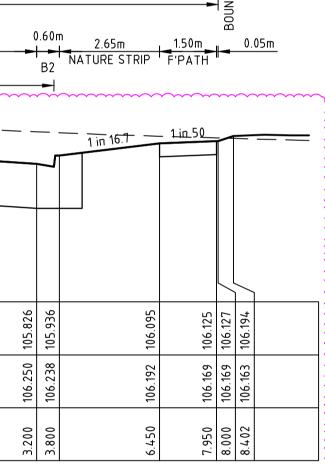

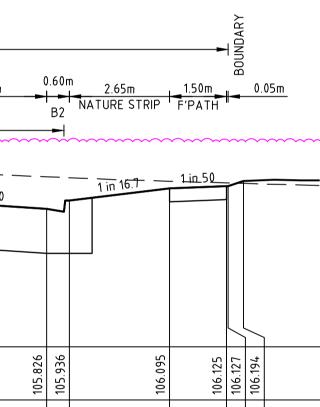


Β


Rev

				Scale						
				H 1:100	0	1	2	3	4	5
				SCALE @ A1 V 1:50	0	0.5	1	1.5	2	2.5
С	SILCRETE STREET RENAMED WINTON DRIVE	M.F	02/02/24							
В	ISSUED FOR APPROVAL	M.F	10/11/23							
А	ISSUED FOR TENDER	M.F.	05/05/23							
Rev	Amendments	Approved	Date							

		1 in	50	1 in 30		1 in 30
DATUM R.L.105.0			1			
DESIGN SURFACE LEVEL	107.206	107.202 107.201	107.171	107.082	106.972	
EXISTING SURFACE LEVEL	106.775	106.775 106.776	106.798	106.798	106.793	
OFFSET	-8.023	-8.000 -7.950	-6.450	– 3.800	-3.200	

WINTON DRIVE

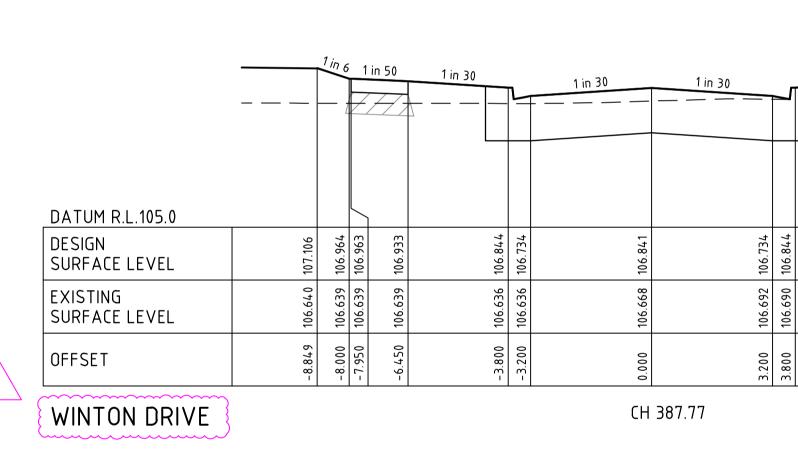


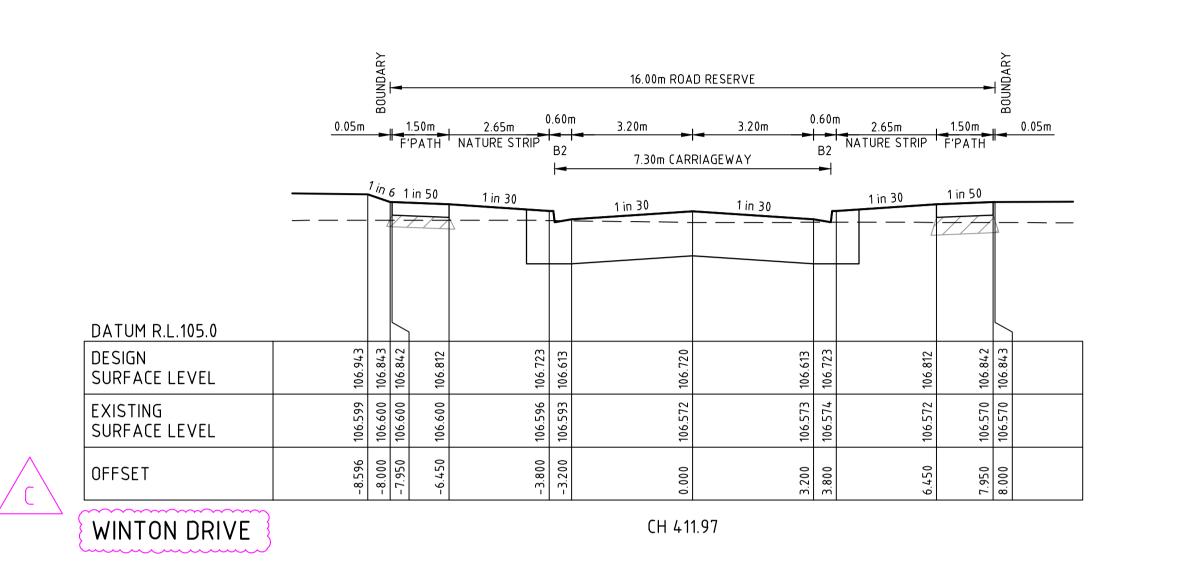



FILLING NOTE ALL FILLING WITHIN ROAD RESERVES IS TO BE UNDERTAKEN USING LEVEL 1 SUPERVISION AND BE COMPLETED IN ACCORDANCE WITH AS 3798-2007 AND TO THE SATISFACTION OF COUNCIL AND THE SUPERINTENDENT. FILL AREAS ARE TO BE STRIPPED OF TOPSOIL. FILLED AND REPLACED WITH TOPSOIL (WHERE REQUIRED) TO OBTAIN THE FINAL LEVELS SHOWN ON THE DRAWINGS.


d t

8403 date

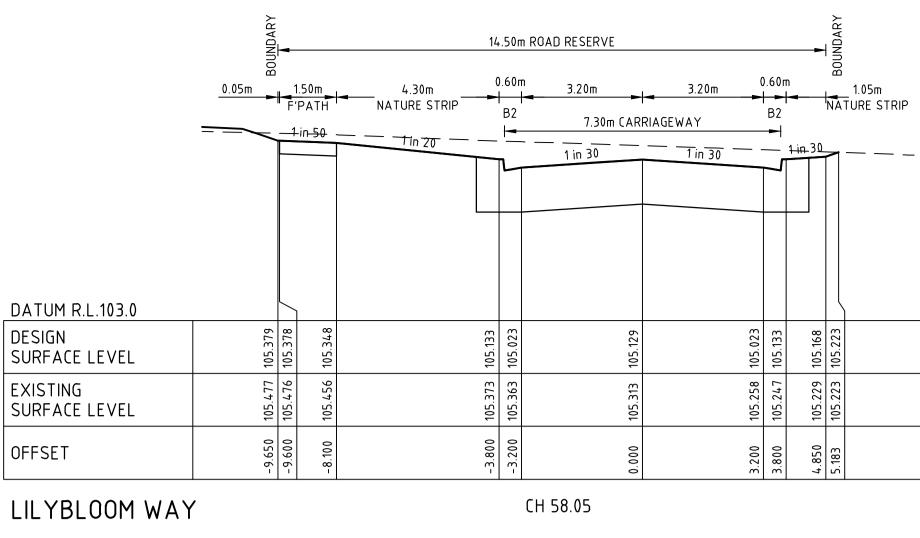

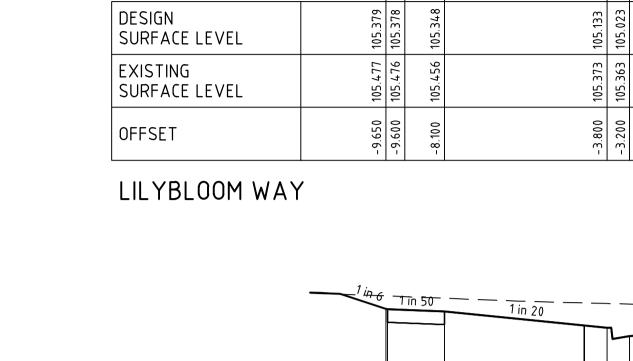


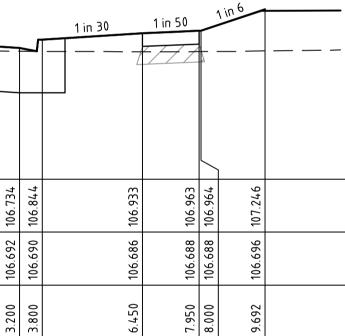

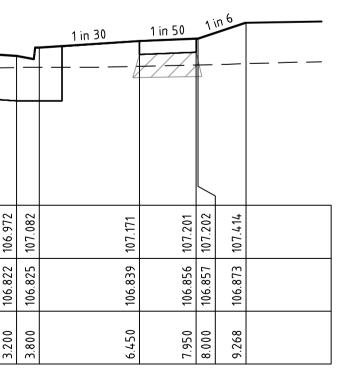

1 in 30

CH 362.77

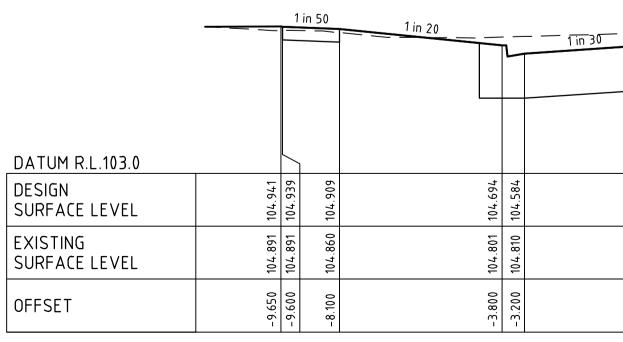

CH 0.00





© Spiire Australia Pty Ltd All Rights Reserved This document is produced by Spiire Australia Pty Ltd solely for the benefit of and use by the client in accordance with the terms of the retainer. Spiire Australia Pty Ltd does not and shall not assume any responsibility or liability whatsoever to any third party arising out of any use or reliance by third party on the content of this document.

spire L6 414 LA TROBE STREET PO BOX 16084 MELBOURNE VICTORIA 8007 AUSTRALIA T 61 3 9993 7888 spiire.com.au ABN 55 050 029 635

Designed P.COLLIER Authorised M.HOLMES Yourland Developments Checked

C.DOBRZELAK Date 14/06/24



FUTURE FINISHED LOT GRADING —

DATUM R.L.103.0

SURFACE LEVEL

SURFACE LEVEL

LILYBLOOM WAY

DESIGN

EXISTING

OFFSET

			īn 50-	1 in 20		1 in 30	1 in 30		1 <del>in 3</del> 0-	tin 6	 
DATUM R.L.103.0	26	24 /	14	67	69	975	869	79	14	8	
SURFACE LEVEL	105.226	105.224	105.194	104.979	104.869	104.9	104.8		105.014	105.118	
EXISTING SURFACE LEVEL	105.398	105.397	105.368	105.297	105.289	105.240	105.170	105.157	105.134	105.118	
OFFSET	- 9.650	-9.600	-8.100	-3.800	-3.200	0.000	3.200	3.800	4.850	5.473	
LILYBLOOM WAY						CH 44.86					

CH 21.64


1 in 6	-	in <del>50</del> –	1in 20						- ••	:- 6	
				ľ	1 in 30	1 in 30			<del>iπ 3</del> 04		
							_				
	$\leq$										
105.109	105.108	105.078	104.863	104.753	104.859		CC1.401	104.863	104.898	105.011	
105.236	105.235	105.199	105.115	105.108	105.073	C C C	140.CUI	105.032	105.018	105.011	
-9.650	-9.600	-8.100	- 3.800	-3.200	0000	c c r	3.400	3.800	4.850	5.529	

	1 in 30			1 <del>-in -</del>	30-	1 in	6	 	_
104.691		104.584	104.694		104.729	104.819			
104.849		104.830	104.827		104.822	104.819			
0.000		3.200	3.800		4.850	5.390			


SOCIETY 1056 **STAGE 1** ROAD & DRAINAGE **ROAD CROSS SECTIONS - SHEET 4** MELTON CITY COUNCIL YOURLAND PRELIMINARY 309675-001CR403

Rev


С

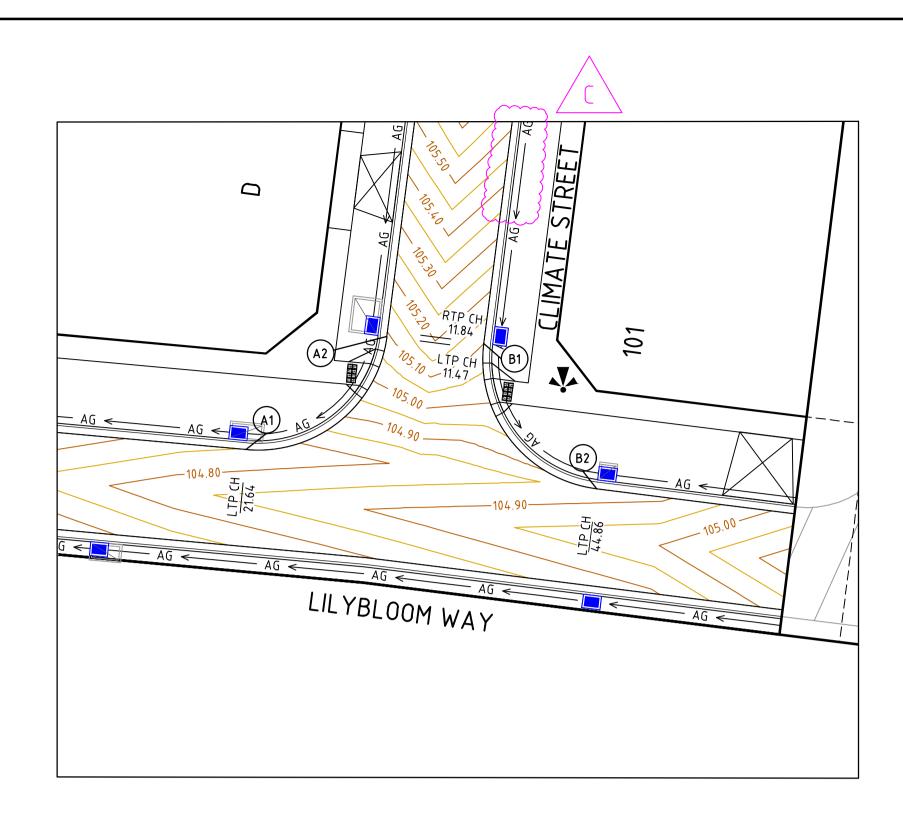



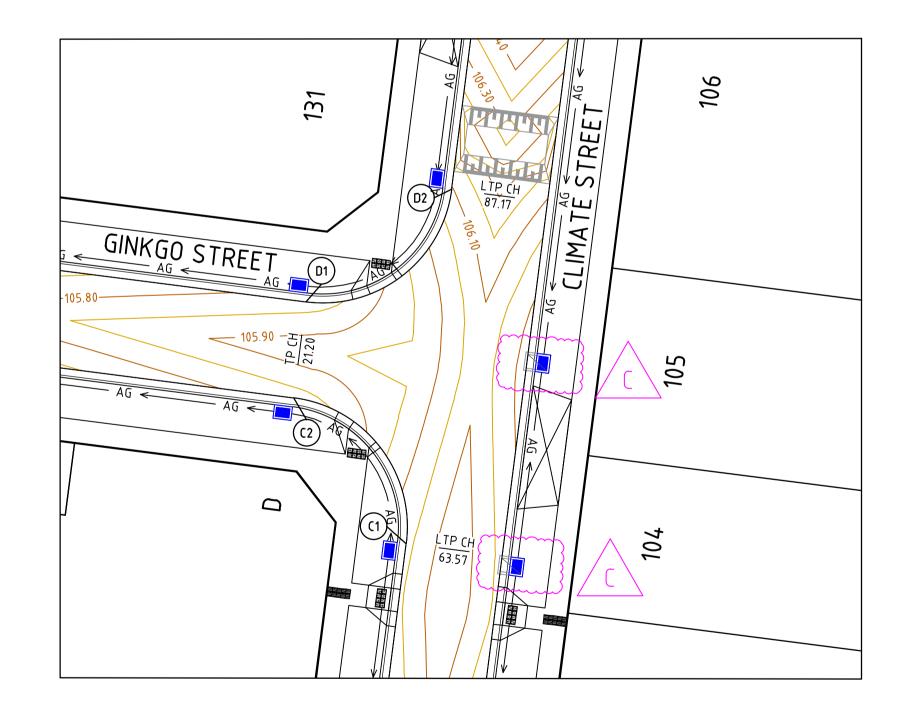


				Scale
				DETAIL PLAN
				H 1:250 0 2.5 5 7.5 10 12.5
				SCALE @ A1
				LIP PROFILE
С	PITS AMENDED	M.H	14/06/24	
В	ISSUED FOR APPROVAL	M.F	10/11/23	H 1:250 0 2.5 5 7.5 10 12.5 SCALE @ A1
А	ISSUED FOR TENDER	M.F.	05/05/23	
Rev	Amendments	Approved	Date	

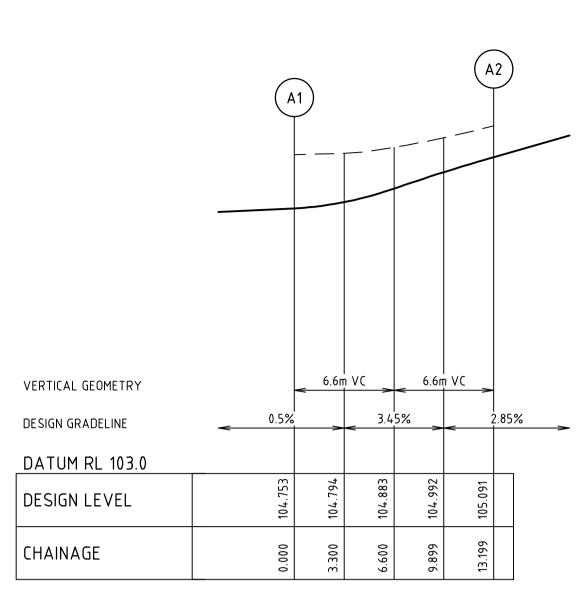

# ALIGNMENT A

#### ALIGNMENT A

POINT NO A1 1/4 1/2 3/4 A2	E A S T I N G 2 9 7 4 6 6 . 2 1 2 2 9 7 4 6 9 . 4 7 5 2 9 7 4 7 2 . 3 7 8 2 9 7 4 7 4 . 4 9 8 2 9 7 4 7 5 . 5 2 8	N O R T H I N G 5 8 2 3 0 5 9 . 4 4 5 8 2 3 0 5 9 . 7 7 5 8 2 3 0 6 1 . 2 9 5 8 2 3 0 6 3 . 7 9 5 8 2 3 0 6 6 . 9 1	1 104.794 7 104.883 9 104.992	
C U R V E	RADIUS ARC		MID ORD	QTR ORD
A 1 – A 2	8.600 13.1		2.410	-0.625

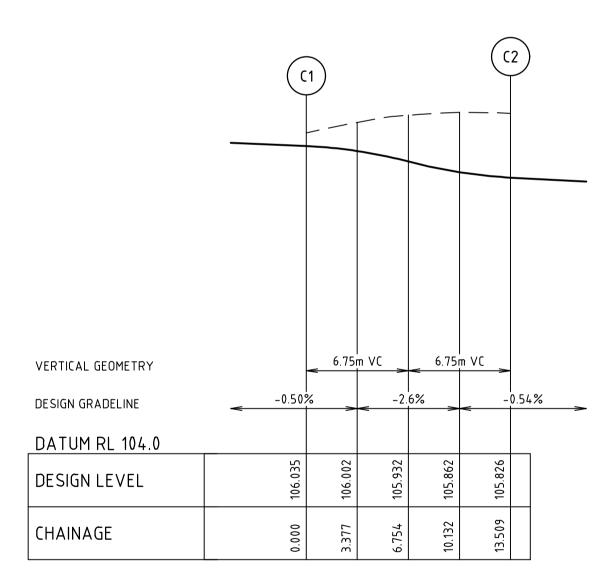

# ALIGNMENT C

ALIGNM	1ENT C			
P 0   N T	N 0 E A S T I N G	N O R T H I N G	R L	
C 1	2 9 7 4 8 2 . 1 5 1	5 8 2 3 1 1 8 . 5 8 8	1 0 6 . 0 3 5	
1 / 4	2 9 7 4 8 1 . 9 2 0	5 8 2 3 1 2 1 . 9 3 6	1 0 6 . 0 0 2	
1 / 2	2 9 7 4 8 0 . 4 2 6	5 8 2 3 1 2 4 . 9 4 0	1 0 5 . 9 3 2	
3 / 4	2 9 7 4 7 7 . 8 9 6	5 8 2 3 1 2 7 . 1 4 4	1 0 5 . 8 6 2	
C 2	2 9 7 4 7 4 . 7 1 4	5 8 2 3 1 2 8 . 2 1 2	1 0 5 . 8 2 6	
C U R V E	RADIUS ARC		MID ORD	QTR ORD
C 1 – C 2	8.600 13.		2.519	-0.655





L6 414 LA TROBE STREET PO BOX 16084 MELBOURNE VICTORIA 8007 AUSTRALIA T 61 3 9993 7888 ABN 55 050 029 635 spiire.com.au


CHOR KERB RETURN SETOUT DETAIL

VER
DESI
DA
DES
CHA

Yourland Developments Checked C.DOBRZELAK Date

14/06/24


Designed P.COLLIER Authorised M.HOLMES

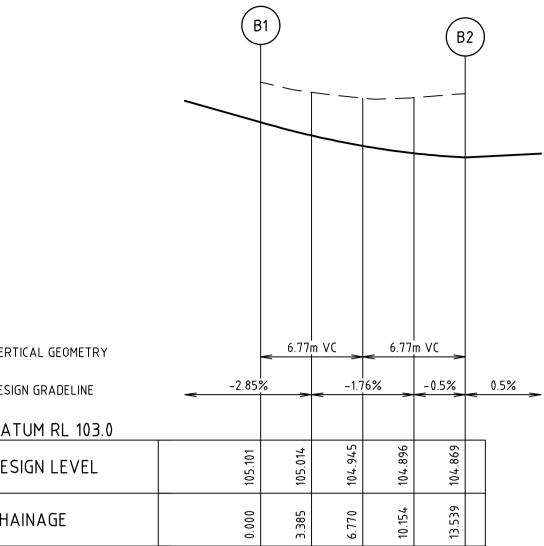

## ALIGNMENT B

#### ALIGNMENT B


ΡΟΙΝΤ	ΝO	E	ΑS	5 T I	Ν	G			Ν	01	7 T I	11	NG	F	۲.						
B 1	2	297	48	31.	9	22		5	82	3 (	060	5.	464	1	05	. 10	1				
1/4	2	97	48	2.	1	55		5 8	32	3 (	) 6 3	3.	109	1	05	. 0 1	4				
1/2	2	97	48	З.	6	57		58	32	3 (	) 6 (	).	100	1	04	. 94	5				
3/4	2	97	48	6.	1	98		5	82	3 (	) 5 '	7.	897	1	04	. 89	6				
B 2	2	297	48	39.	3	89		5	82	3 (	05	5.	836	1	04	. 86	9				
CURVE		RΑ	DΙ	US		ΑŔ	С	L		(	СΗО	3 R	D	ΜI	D	0 R D		Q	ΤR	C	) R D
B 1 – B 2		8.	60	0 (		13	. 5	3	9		12	. 1	84	2.	53	0	-	. 0	. 6 !	58	}

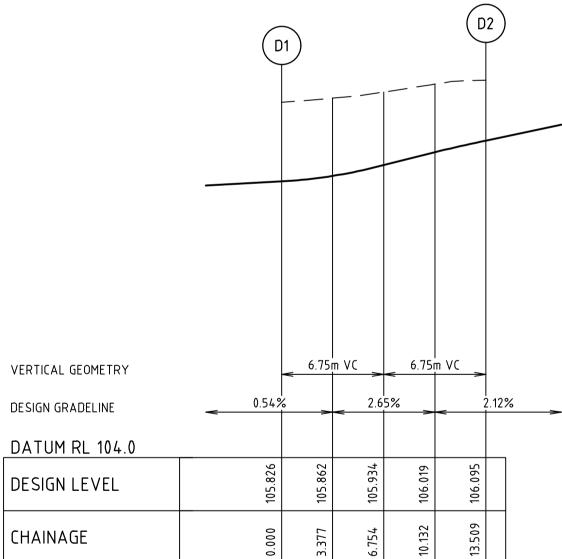


## ALIGNMENT D


ALIGNM	IENT D				
) 1 / 4 / 2	N O E A S T I N 2 9 7 4 7 5 . 5 2 9 7 4 7 8 . 8 2 9 7 4 8 1 . 8 2 9 7 4 8 4 . 0 2 9 7 4 8 5 . 1	2 8 5 8 2 3 7 6 5 8 2 3 8 0 5 8 2 3	134.790 136.285 138.815	106.019	
U R V E 0 1 – D 2		ARCL 13.509			QTR ORD -0.655

SOCIETY 1056 STAGE 1 ROAD AND DRAINAGE INTERSECTION DETAILS - SHEET 1 MELTON CITY COUNCIL YOURLAND	
PRELIMINARY 309675-001CR500	Rev C

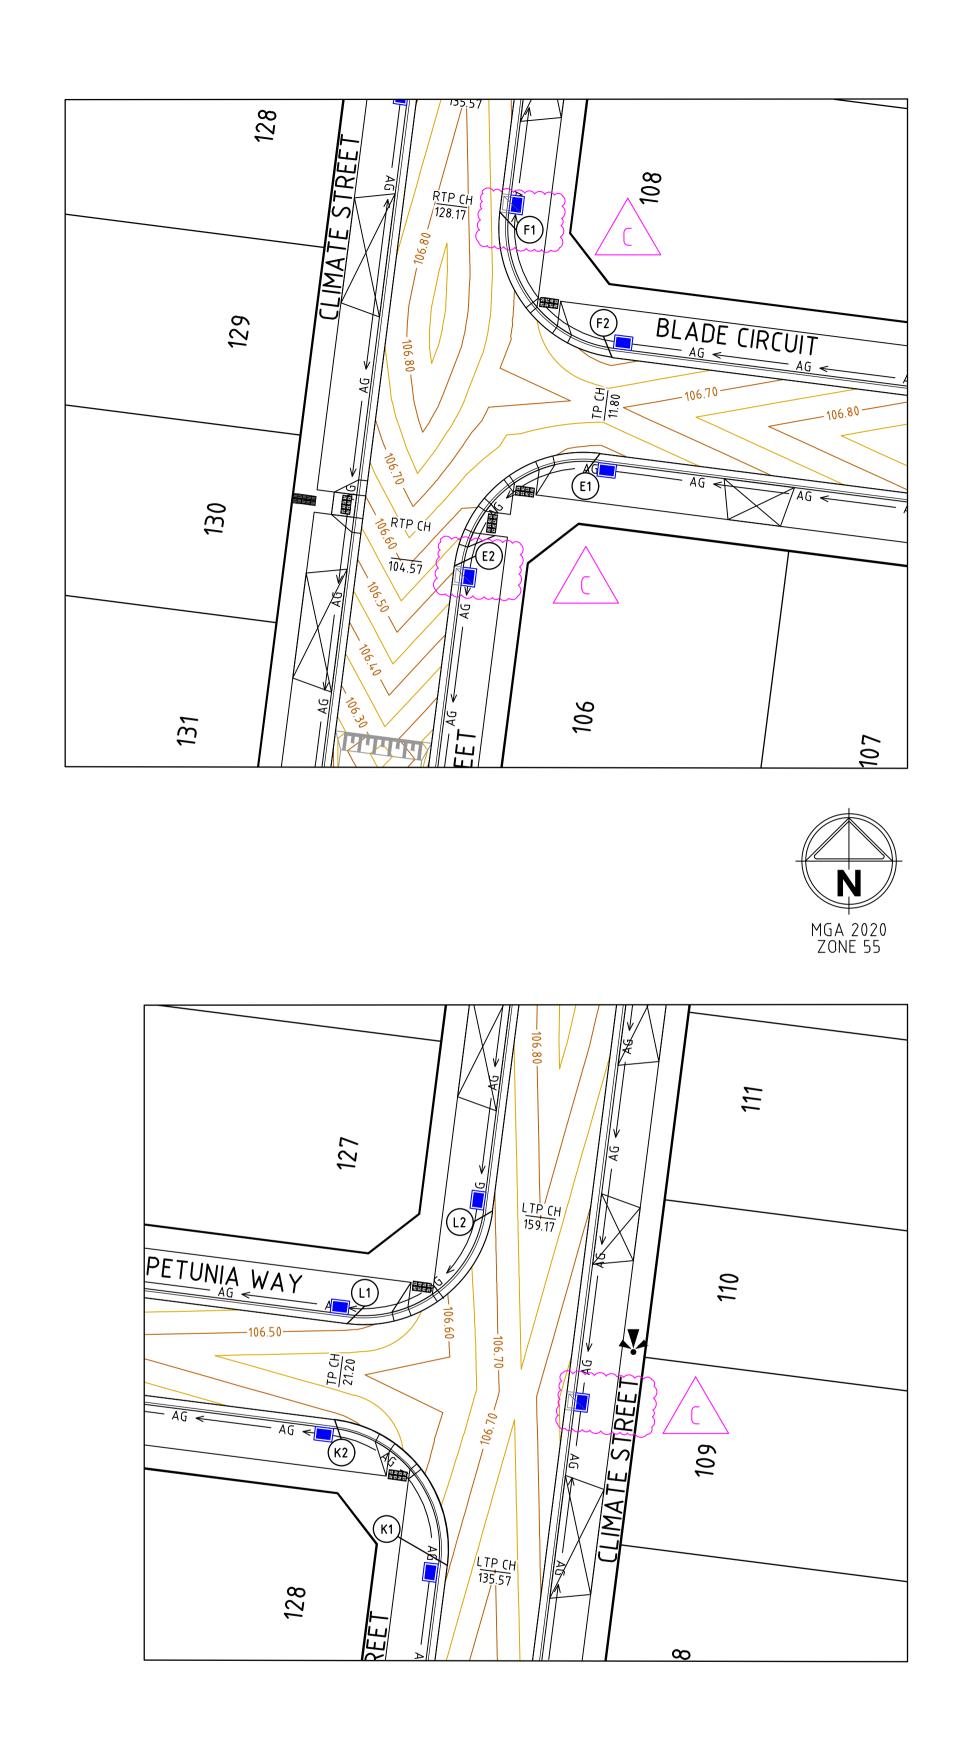

				Scale
				DETAIL PLAN
				H 1:250 0 2 <u>.5 5 7.5 1</u> 0 12.5
				SCALE @ A1
				LIP PROFILE
С	PITS AMENDED	M.H	14/06/24	
В	ISSUED FOR APPROVAL	M.F	10/11/23	H 1:250 0 2.5 5 7.5 10 12.5 SCALE @ A1
А	ISSUED FOR TENDER	M.F.	05/05/23	V 1:25 0 0.25 0.50 0.75 1.00 1.25
Rev	Amendments	Approved	Date	

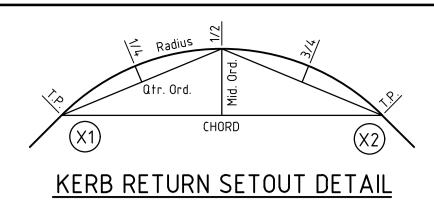


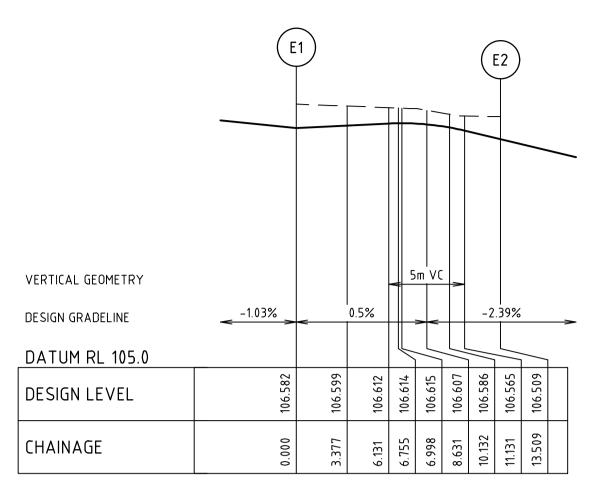

# ALIGNMENT E

#### ALIGNMENT E

POINT E 1	NO EAS	T I N G 3 . 3 3 5		R T H I N G 1 6 5 . 8 7 8	R L 1 0 6 . 5 8 2	
1/4	29749	9.988	5823	165.647	106.599	
1 / 2 3 / 4	2 9 7 4 9 2 9 7 4 9			164.153 161.623	106.614 106.586	
E 2	29749	3.712	5823	158.442	106.509	
CURVE	RADI	US ARC	L	C H O R D	MID ORD	QTR ORI
E 1 – E 2	8.60	0 13.5	09	12.162	2.519	-0.655

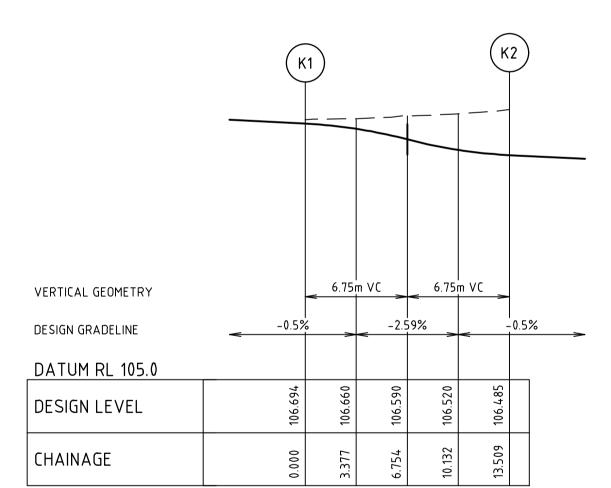

# ALIGNMENT K

ALIGNM	1ENT K			
P 0   N T	N O E A S T I N G	N O R T H I N G	R L	
K 1	2 9 7 4 9 1 . 3 0 5	5 8 2 3 1 9 0 . 0 0 4	1 0 6 . 6 9 4	
1 / 4	2 9 7 4 9 1 . 0 7 4	5 8 2 3 1 9 3 . 3 5 1	1 0 6 . 6 6 0	
1 / 2	2 9 7 4 8 9 . 5 8 0	5 8 2 3 1 9 6 . 3 5 6	1 0 6 . 5 9 0	
3 / 4	2 9 7 4 8 7 . 0 4 9	5 8 2 3 1 9 8 . 5 6 0	1 0 6 . 5 2 0	
K 2	2 9 7 4 8 3 . 8 6 8	5 8 2 3 1 9 9 . 6 2 7	1 0 6 . 4 8 5	
C U R V E		CLCHORD	MID ORD	QTR ORD
K 1 – K 2		.50912.162	2.519 -	-0.655





L6 414 LA TROBE STREET PO BOX 16084 MELBOURNE VICTORIA 8007 AUSTRALIA T 61 3 9993 7888 ABN 55 050 029 635 spiire.com.au


Designed P.COLLIER Authorised M.HOLMES



VER
DESI
DA
DES
CHA

ALI Ρ0 L 1 1/4 1/2


3/4 L 2 C U F L 1 -

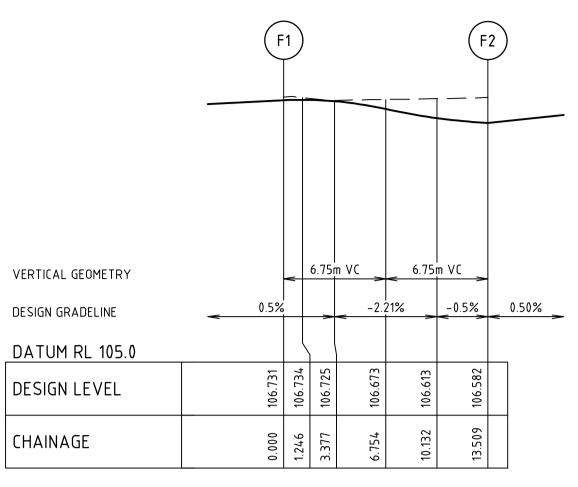

# ALIGNMENT F

ALIGNM	1ENT	F			
ΡΟΙΝΤ		F	٨	c	

P 0   N T	N O E A S T I N G	N O R T H I N G	R L	
F 1	2 9 7 4 9 6 . 7 1 2	5 8 2 3 1 8 1 . 8 5 0	1 0 6 . 7 3 1	
1 / 4	2 9 7 4 9 6 . 9 4 3	5 8 2 3 1 7 8 . 5 0 2	1 0 6 . 7 2 5	
1 / 2	2 9 7 4 9 8 . 4 3 8	5 8 2 3 1 7 5 . 4 9 8	1 0 6 . 6 7 3	
3 / 4	2 9 7 5 0 0 . 9 6 8	5 8 2 3 1 7 3 . 2 9 4	1 0 6 . 6 1 3	
F 2	2 9 7 5 0 4 . 1 4 9	5 8 2 3 1 7 2 . 2 2 6	1 0 6 . 5 8 2	
C U R V E	RADIUS AR	L CHORD	MID ORD	QTR ORD
F 1 – F 2	8.600 13	509 12.162	2.519	-0.655

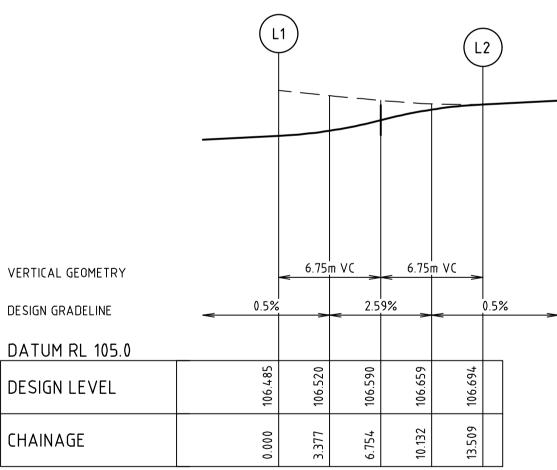


# ALIGNMENT L


IGNM	IENT L								
)   N T   ' 4 ' 2 ' 4 2	2 9 2 9 2 9	74 74 74 74 74	84 88 91 93	. 6 . 0 . . 0 . . 2	8 2 3 0 3 4 3 8	5 8 2 3 5 8 2 3 5 8 2 3 5 8 2 3 5 8 2 3	2 0 6 . 2 0 6 2 0 7 . 7 0 1 2 1 0 . 2 3 1		
J R V E I – L 2				-	A R C 1 3 . 5	-		MID ORD 2.519	Q T R O R D - 0.655

SOCIETY 1056 STAGE 1 ROAD & DRAINAGE INTERSECTION DETAILS - SHEET 2 MELTON CITY COUNCIL YOURLAND	
PRELIMINARY 309675-001CR501	Rev C



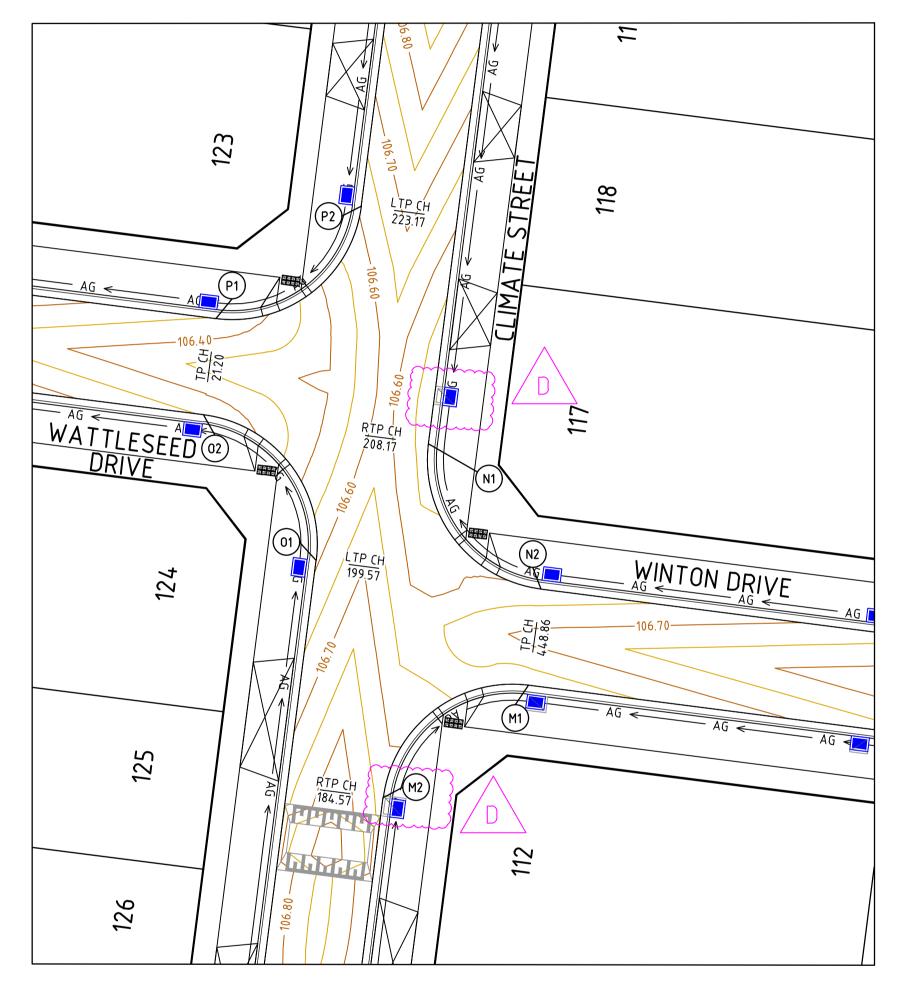

				Scale DETAIL PLAN	SO 900, SO 4500, SO 1400,
				H 1:250 0 2.5 5 7.5 10 12.5	
				SCALE @ A1	Sustan Ostificad
D	PITS AMENDED	M.H	14/06/24	LIP PROFILE	System Certified
С	SILCRETE STREET RENAMED WINTON DRIVE	M.F	02/02/24		© Spiire Australia Pty Ltd All Rights Reserved This document is produced by Spiire Australia Pty Ltd solely for the
В	ISSUED FOR APPROVAL	M.F	10/11/23	H 1:250 0 2.5 5 7.5 10 12.5 SCALE @ A1	benefit of and use by the client in accordance with the terms of the
А	ISSUED FOR TENDER	M.F.	05/05/23	V 1:25 0 0.25 0.50 0.75 1.00 1.25	retainer. Spiire Australia Pty Ltd does not and shall not assume any responsibility or liability whatsoever to any third party arising out of
Rev	Amendments	Approved	Date		any use or reliance by third party on the content of this document.

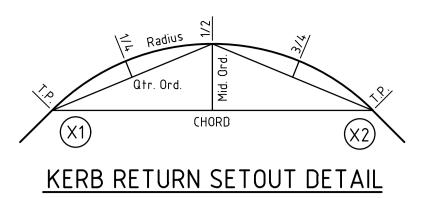


	M	1			M	2
VERTICAL GEOMETRY		6.75	n VC 🔉	6.75	m VC	
DESIGN GRADELINE	-0.5%	<0.5%	<b>-</b> 1.0	9%	<   0	.81%
DATUM RL 105.0						
DESIGN LEVEL	106.613	106.635	106.667	106.702	106.731	
CHAINAGE	0.000	3.377	6.754	10.132	13.509	

# ALIGNMENT M

ALIGNMENT	Μ	

P 0   N T	N 0 E A S T I N G	N O R T H I N G	R L	
M 1	2 9 7 5 1 3 . 5 0 6	5 8 2 3 2 4 5 . 2 2 6	1 0 6 . 6 1 3	
1 / 4	2 9 7 5 1 0 . 1 5 8	5 8 2 3 2 4 4 . 9 9 6	1 0 6 . 6 3 5	
1 / 2	2 9 7 5 0 7 . 1 5 4	5 8 2 3 2 4 3 . 5 0 1	1 0 6 . 6 6 7	
3 / 4	2 9 7 5 0 4 . 9 5 0	5 8 2 3 2 4 0 . 9 7 1	1 0 6 . 7 0 2	
M 2	2 9 7 5 0 3 . 8 8 2	5 8 2 3 2 3 7 . 7 9 0	1 0 6 . 7 3 1	
C U R V E	RADIUS ARC		MID ORD	Q T R O R D
M 1 – M 2	8.600 13.		2.519	- 0.655

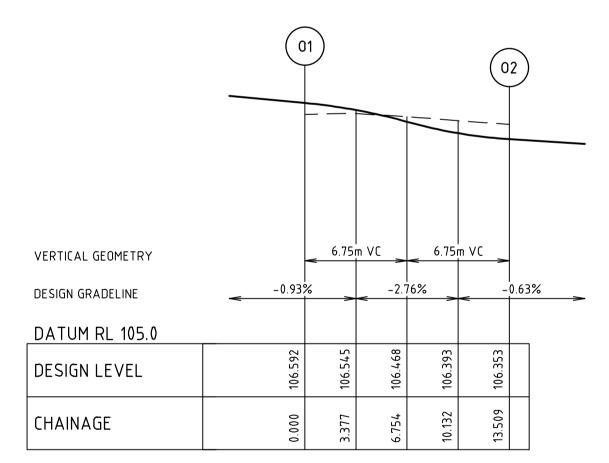

# ALIGNMENT O

#### ALIGNMENT O

P 0   N T	N 0 E A S T I N G	N O R T H I N G	R L	
0 1	2 9 7 4 9 9 . 4 4 2	5 8 2 3 2 5 3 . 4 8 4	1 0 6 . 5 9 2	
1 / 4	2 9 7 4 9 9 . 2 1 1	5 8 2 3 2 5 6 . 8 3 2	1 0 6 . 5 4 5	
1 / 2	2 9 7 4 9 7 . 7 1 7	5 8 2 3 2 5 9 . 8 3 6	1 0 6 . 4 6 8	
3 / 4	2 9 7 4 9 5 . 1 8 6	5 8 2 3 2 6 2 . 0 4 0	1 0 6 . 3 9 3	
0 2	2 9 7 4 9 2 . 0 0 5	5 8 2 3 2 6 3 . 1 0 8	1 0 6 . 3 5 3	
C U R V E	RADIUS ARC	L CHORD	MID ORD	QTR ORD
O 1 - O 2	8.600 13.	509 12.162	2.519	-0.655





L6 414 LA TROBE STREET PO BOX 16084 MELBOURNE VICTORIA 8007 AUSTRALIA T 61 3 9993 7888 ABN 55 050 029 635 spiire.com.au

Designed P.COLLIER Authorised M.HOLMES



14/06/24


DESI
DA
DES
CHA
AL

ALI

Ρ0 P 1 1/4 1/2 3/4 P 2

С U F Р 1 -


Ρ0 N 1 1/4 1/2 3/4 N 2 C U F N 1 -

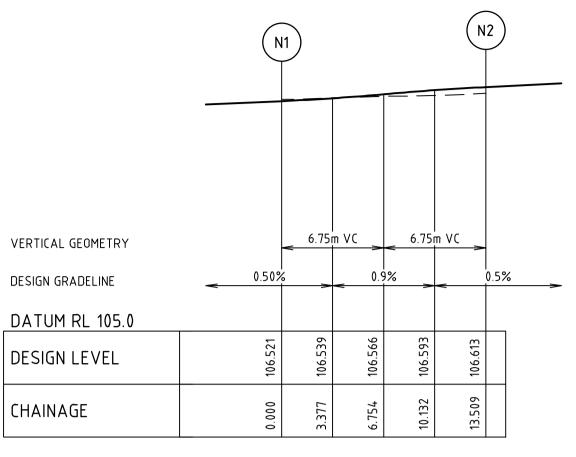

# ALIGNMENT N

#### ALIGNMENT N


DINT	NO EASTING	NORTHING	RL	
	297506.883	5823261.198	106.521	
4	297507.114	5823257.851	106.539	
2	297508.608	5823254.846	106.566	
	297511.139	5823252.642	106.593	
2	297514.320	5823251.575	106.613	
JRVE	RADIUS ARC	L CHORD	MID ORD	QTR ORD
I – N 2	8.600 13.	509 12.162	2.519	-0.655

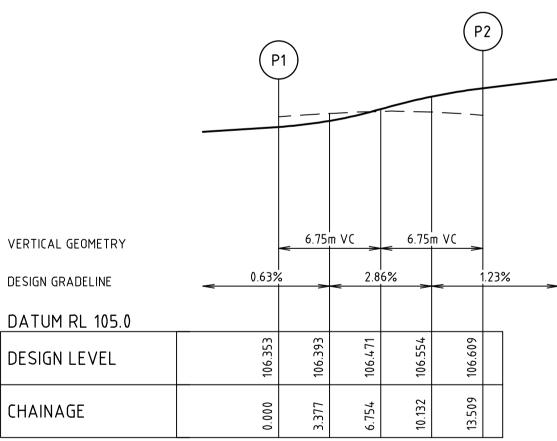

#### LIGNMENT P

LIGNME	NT P			
1 7 4 7 2 7 4		5 8 2 3 2 6 9 . 4 5 6 5 8 2 3 2 6 9 . 6 8 7	1 0 6 . 3 5 3 1 0 6 . 3 9 3 1 0 6 . 4 7 1 1 0 6 . 5 5 4	
J R V E 1 – P 2		CLCHORD .50912.162	MID ORD 2.519	QTR ORD -0.655

PRELIMINARY 309675-001CR502	Rev
MELTON CITY COUNCIL YOURLAND	
ROAD & DRAINAGE INTERSECTION DETAILS - SHEET 3	
SOCIETY 1056 STAGE 1	

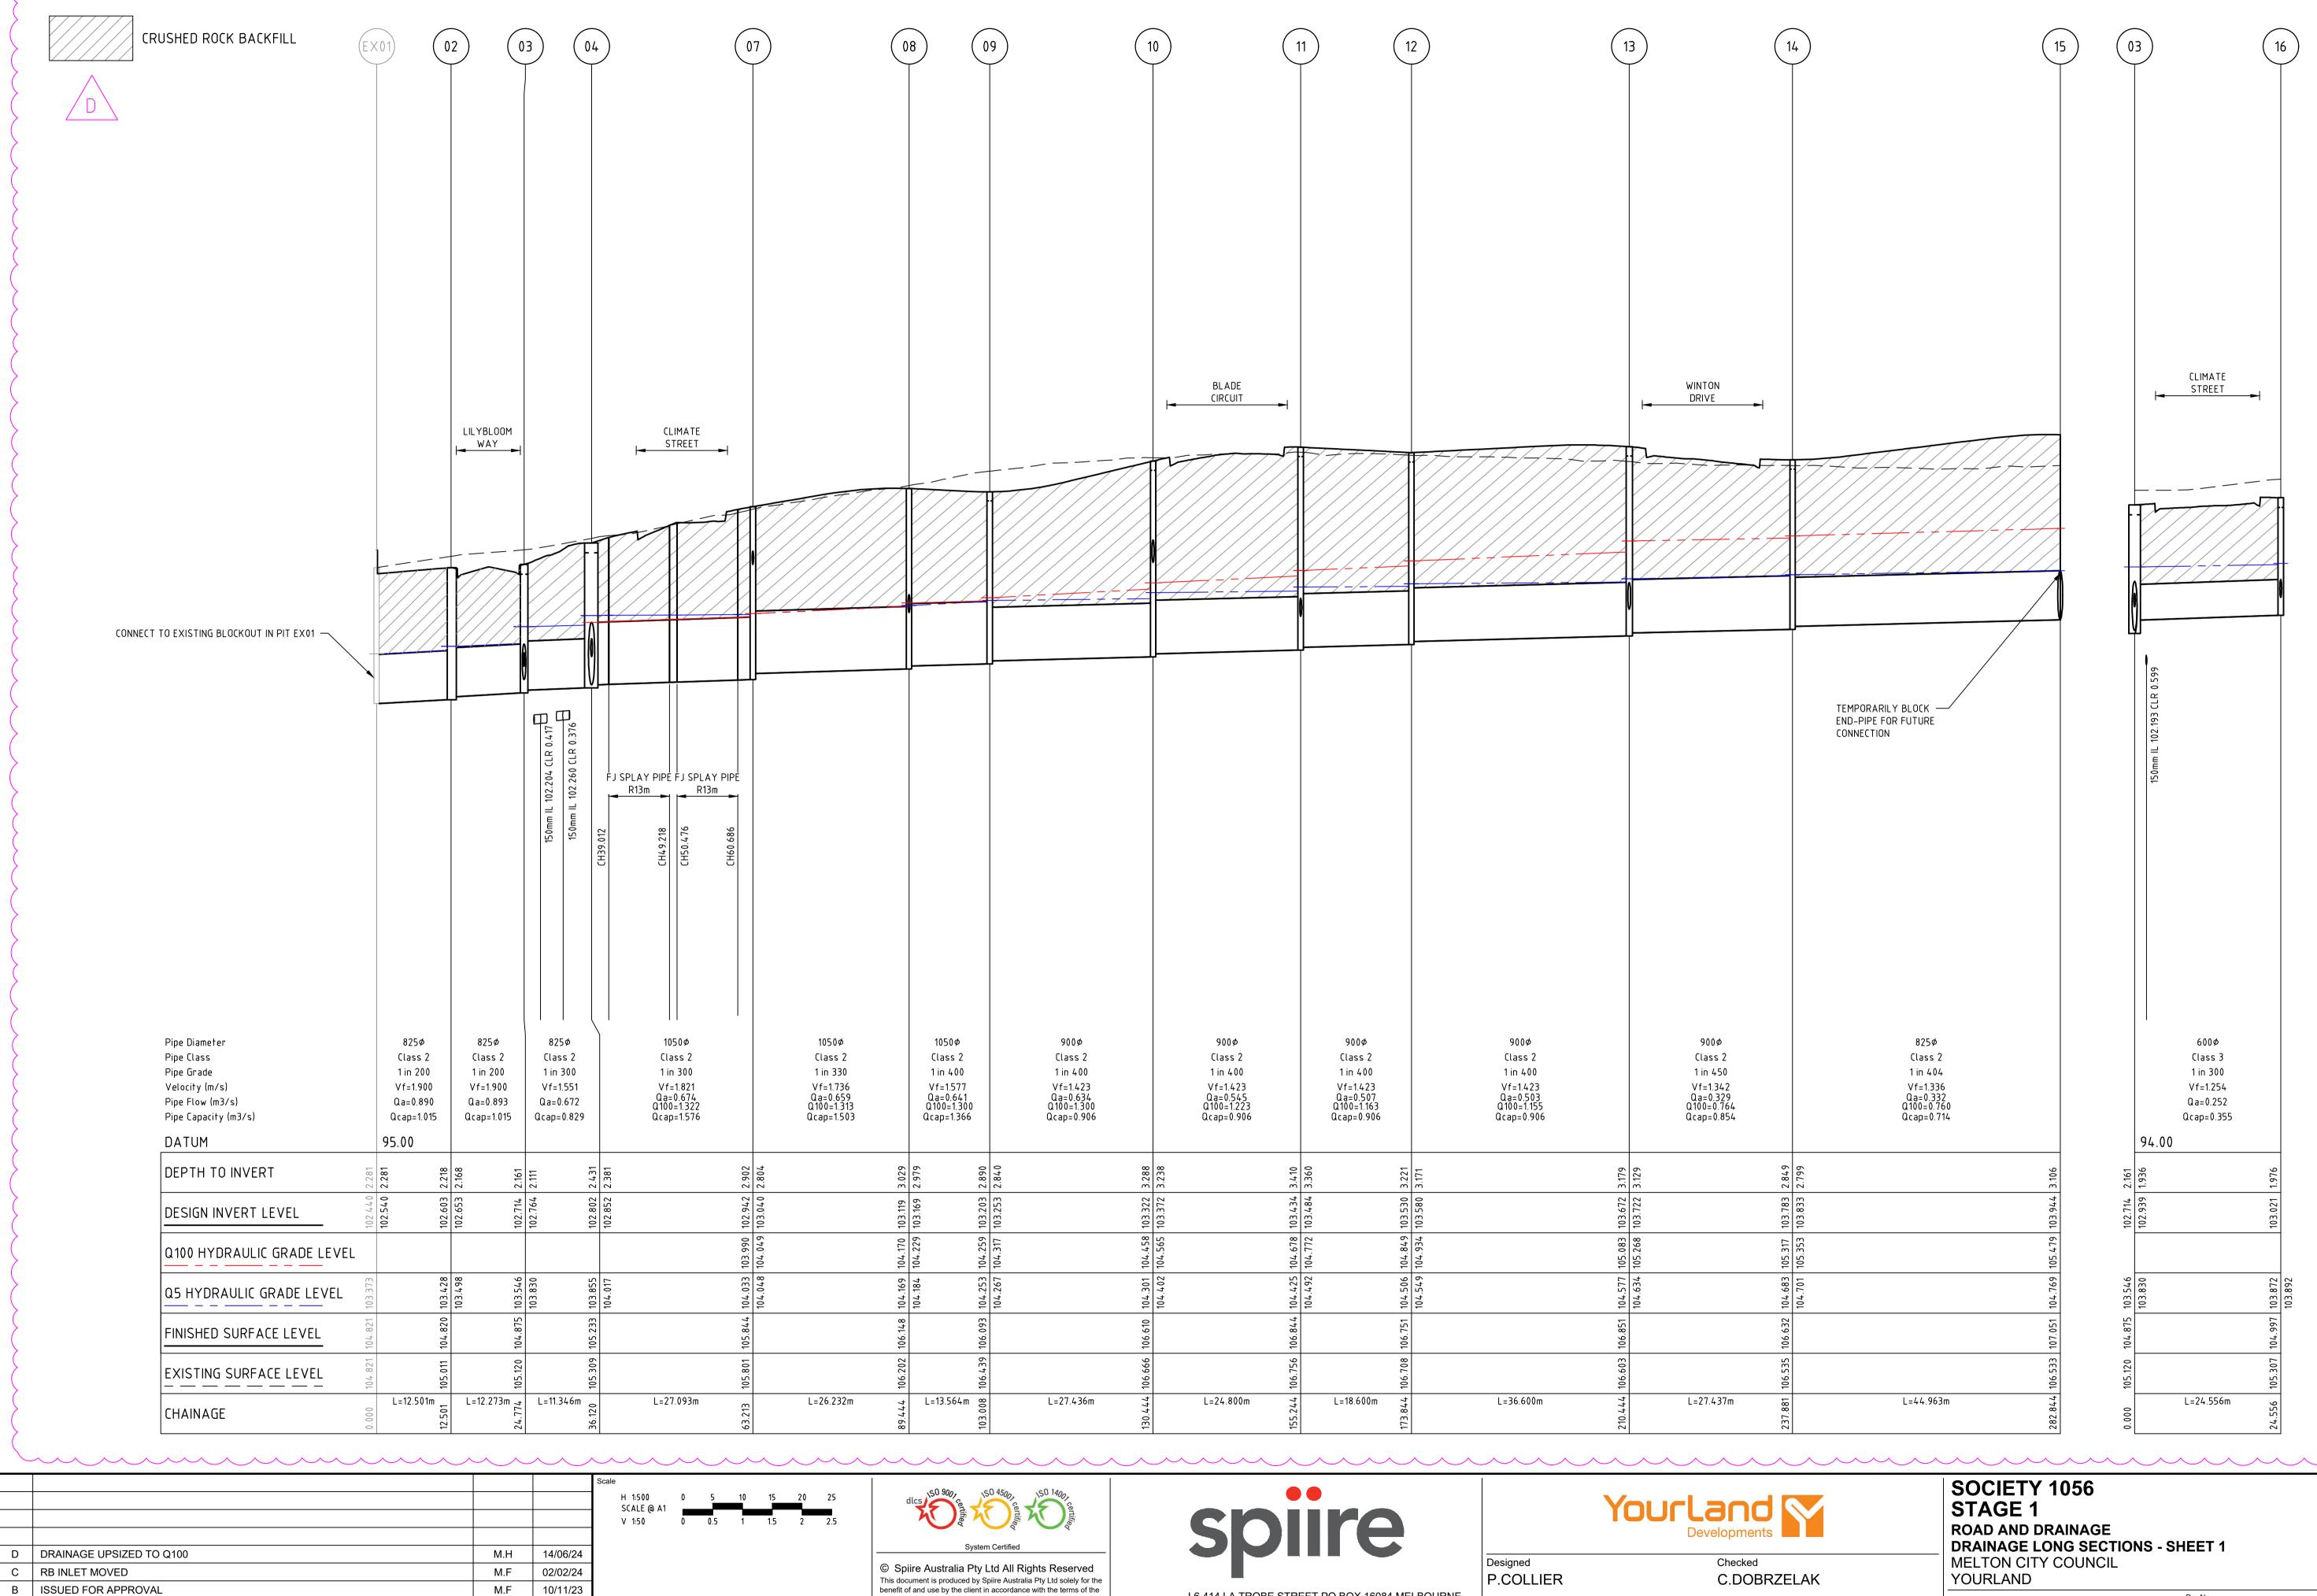

M.F.

Approved

05/05/23

Date


A ISSUED FOR TENDER

Rev Amendments

		(9)	10			2)	13 (	14
			BLADE CIRCUIT	-1			WINTON DRIVE	
					7777			
				0				
	1050 <i>Φ</i> Class 2 1 in 400 Vf=1.577 Qa=0.641 Q100=1.300 Qcap=1.366	900¢ Class 2 1 in 400 Vf=1.423 Qa=0.634 Q100=1.300 Qcap=0.906	900ø Class 2 1 in 400 Vf=1.423 Qa=0.545 Q100=1.223 Qcap=0.906		900Ø Class 2 1 in 400 Vf=1.423 Qa=0.507 Q100=1.163 Qcap=0.906	900ø Class 2 1 in 400 Vf=1.423 Qa=0.503 Q100=1.155 Qcap=0.906	900ø Class 2 1 in 450 Vf=1.342 Qa=0.329 Q100=0.764 Qcap=0.854	
9 3.029		53 2.84.0	22 3.238 72 3.238	34 3.410 84 3.360				33 2.849 33 2.799
104.170 103.119	104.229 103.169 104.259 103.203	104.317 103.253	104.565 103.372 104.565 103.372	104.678 103.434 104.772 103.484	103.52			105.317         103.783           105.353         103.833
104.169	104.184	104.267	104.402 104.402	104.425 104.492	104.506	104.549	104.634 104.634	104.683 104.701
02 106.148	39 106.093		666 106.610	56 106.844	08 106.751			35 106.632
89.444 106.202			9999901 777 L=24.800m	155.244 106.756	T=18.600m 173.844 106.708	L=36.600m		237.881 106.535
89.	10		<u>٤</u>	15.	173		17	23




Designed P.COLLIER Authorised M.HOLMES

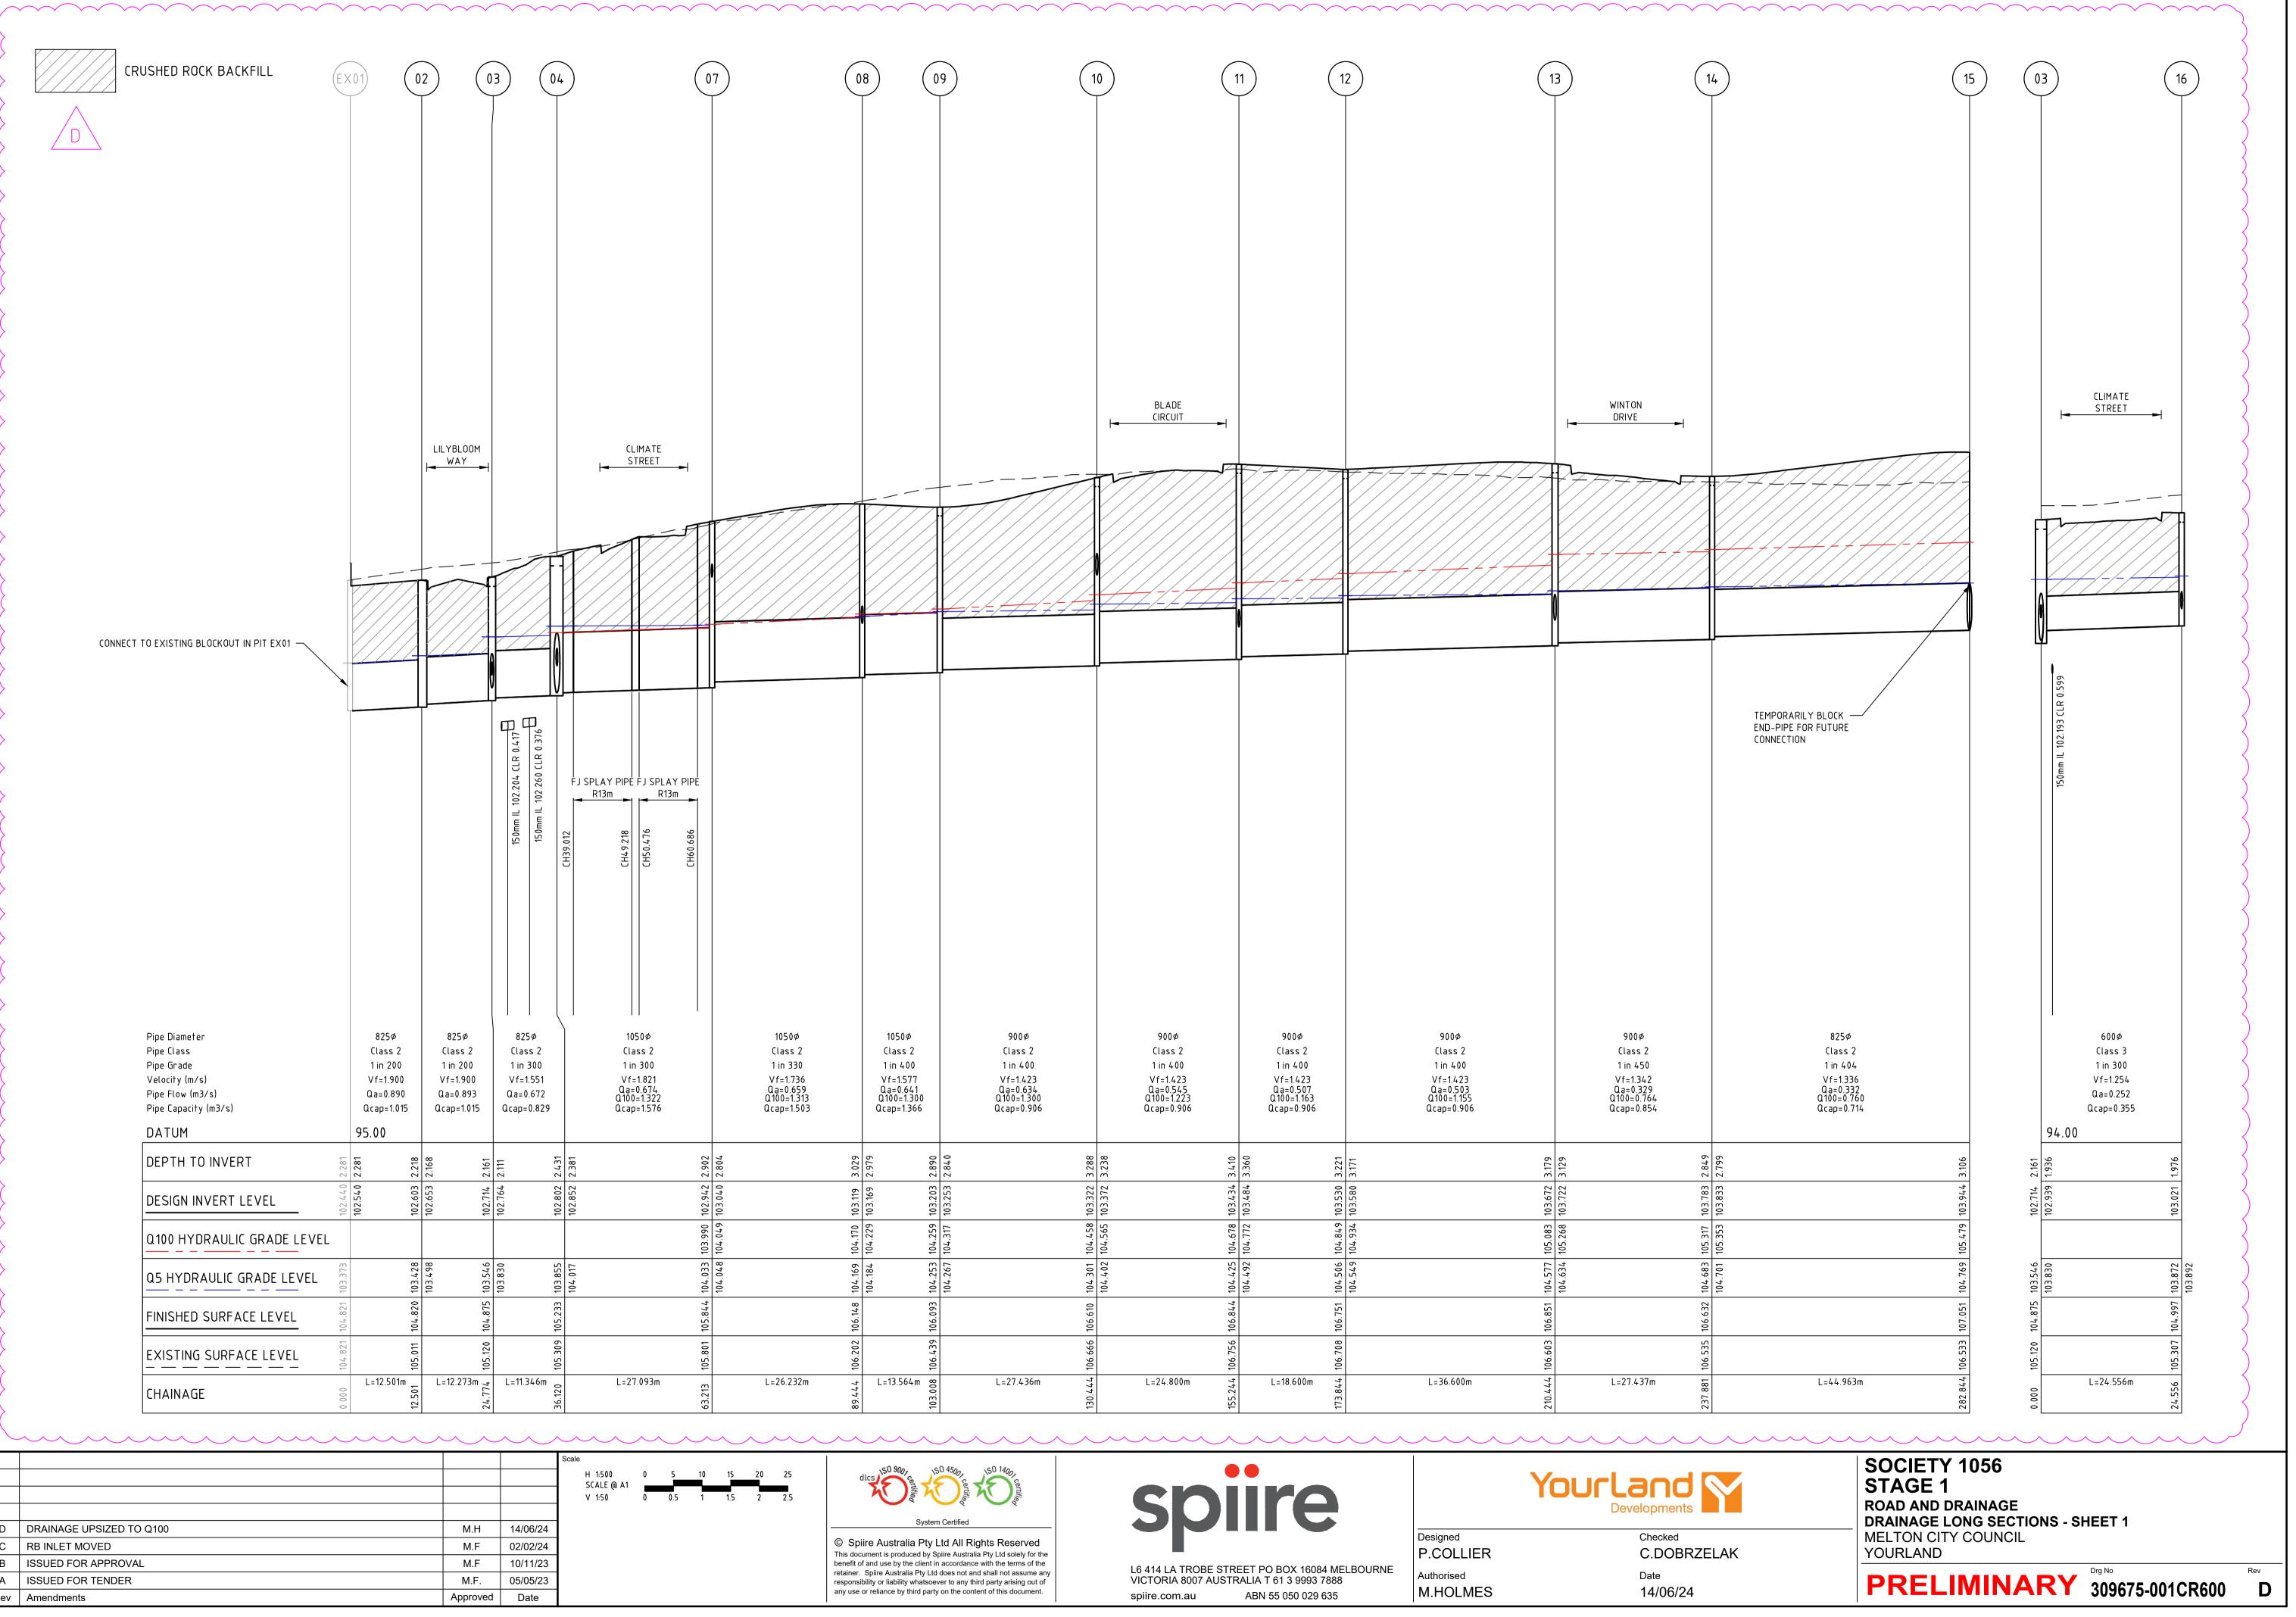


This document is produced by Spiire Australia Pty Ltd solely for the benefit of and use by the client in accordance with the terms of the retainer. Spiire Australia Pty Ltd does not and shall not assume any responsibility or liability whatsoever to any third party arising out of any use or reliance by third party on the content of this document.


L6 414 LA TROBE STREET PO BOX 16084 MELBOURNE VICTORIA 8007 AUSTRALIA T 61 3 9993 7888 spiire.com.au ABN 55 050 029 635

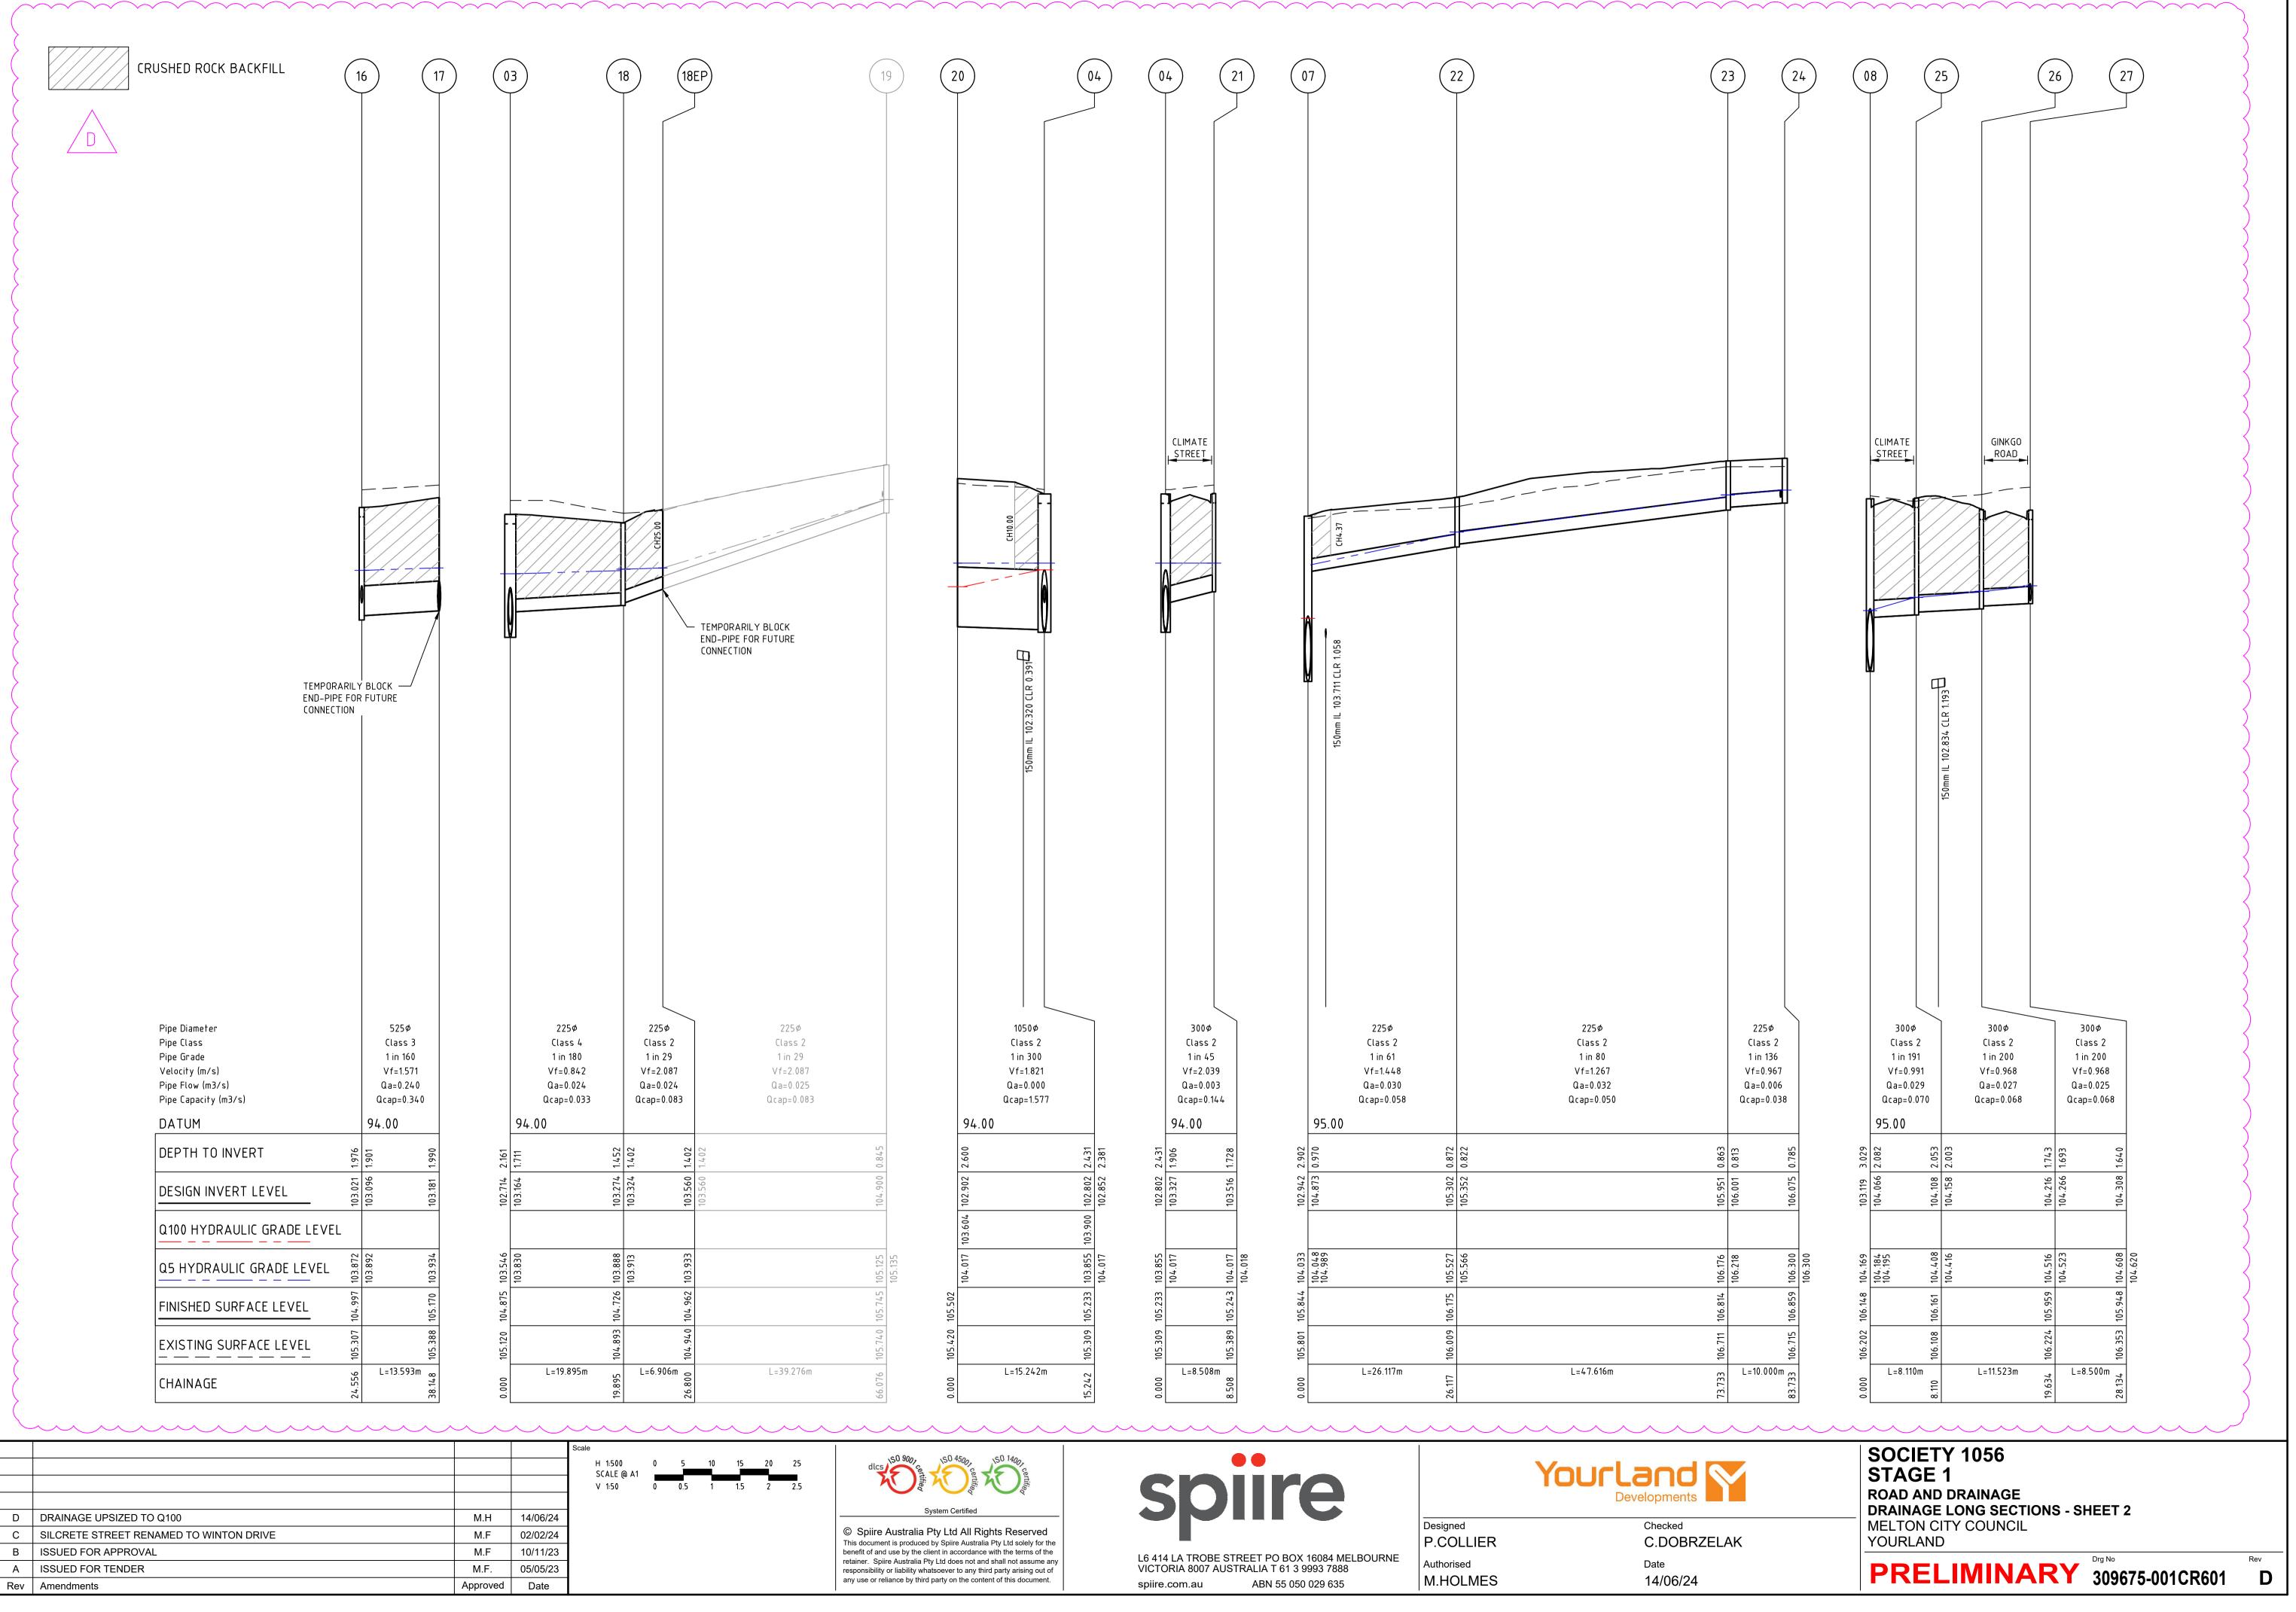

plotted by Winnie 14/06/2024 3:59 F 8601 date 5-قھ ЯG

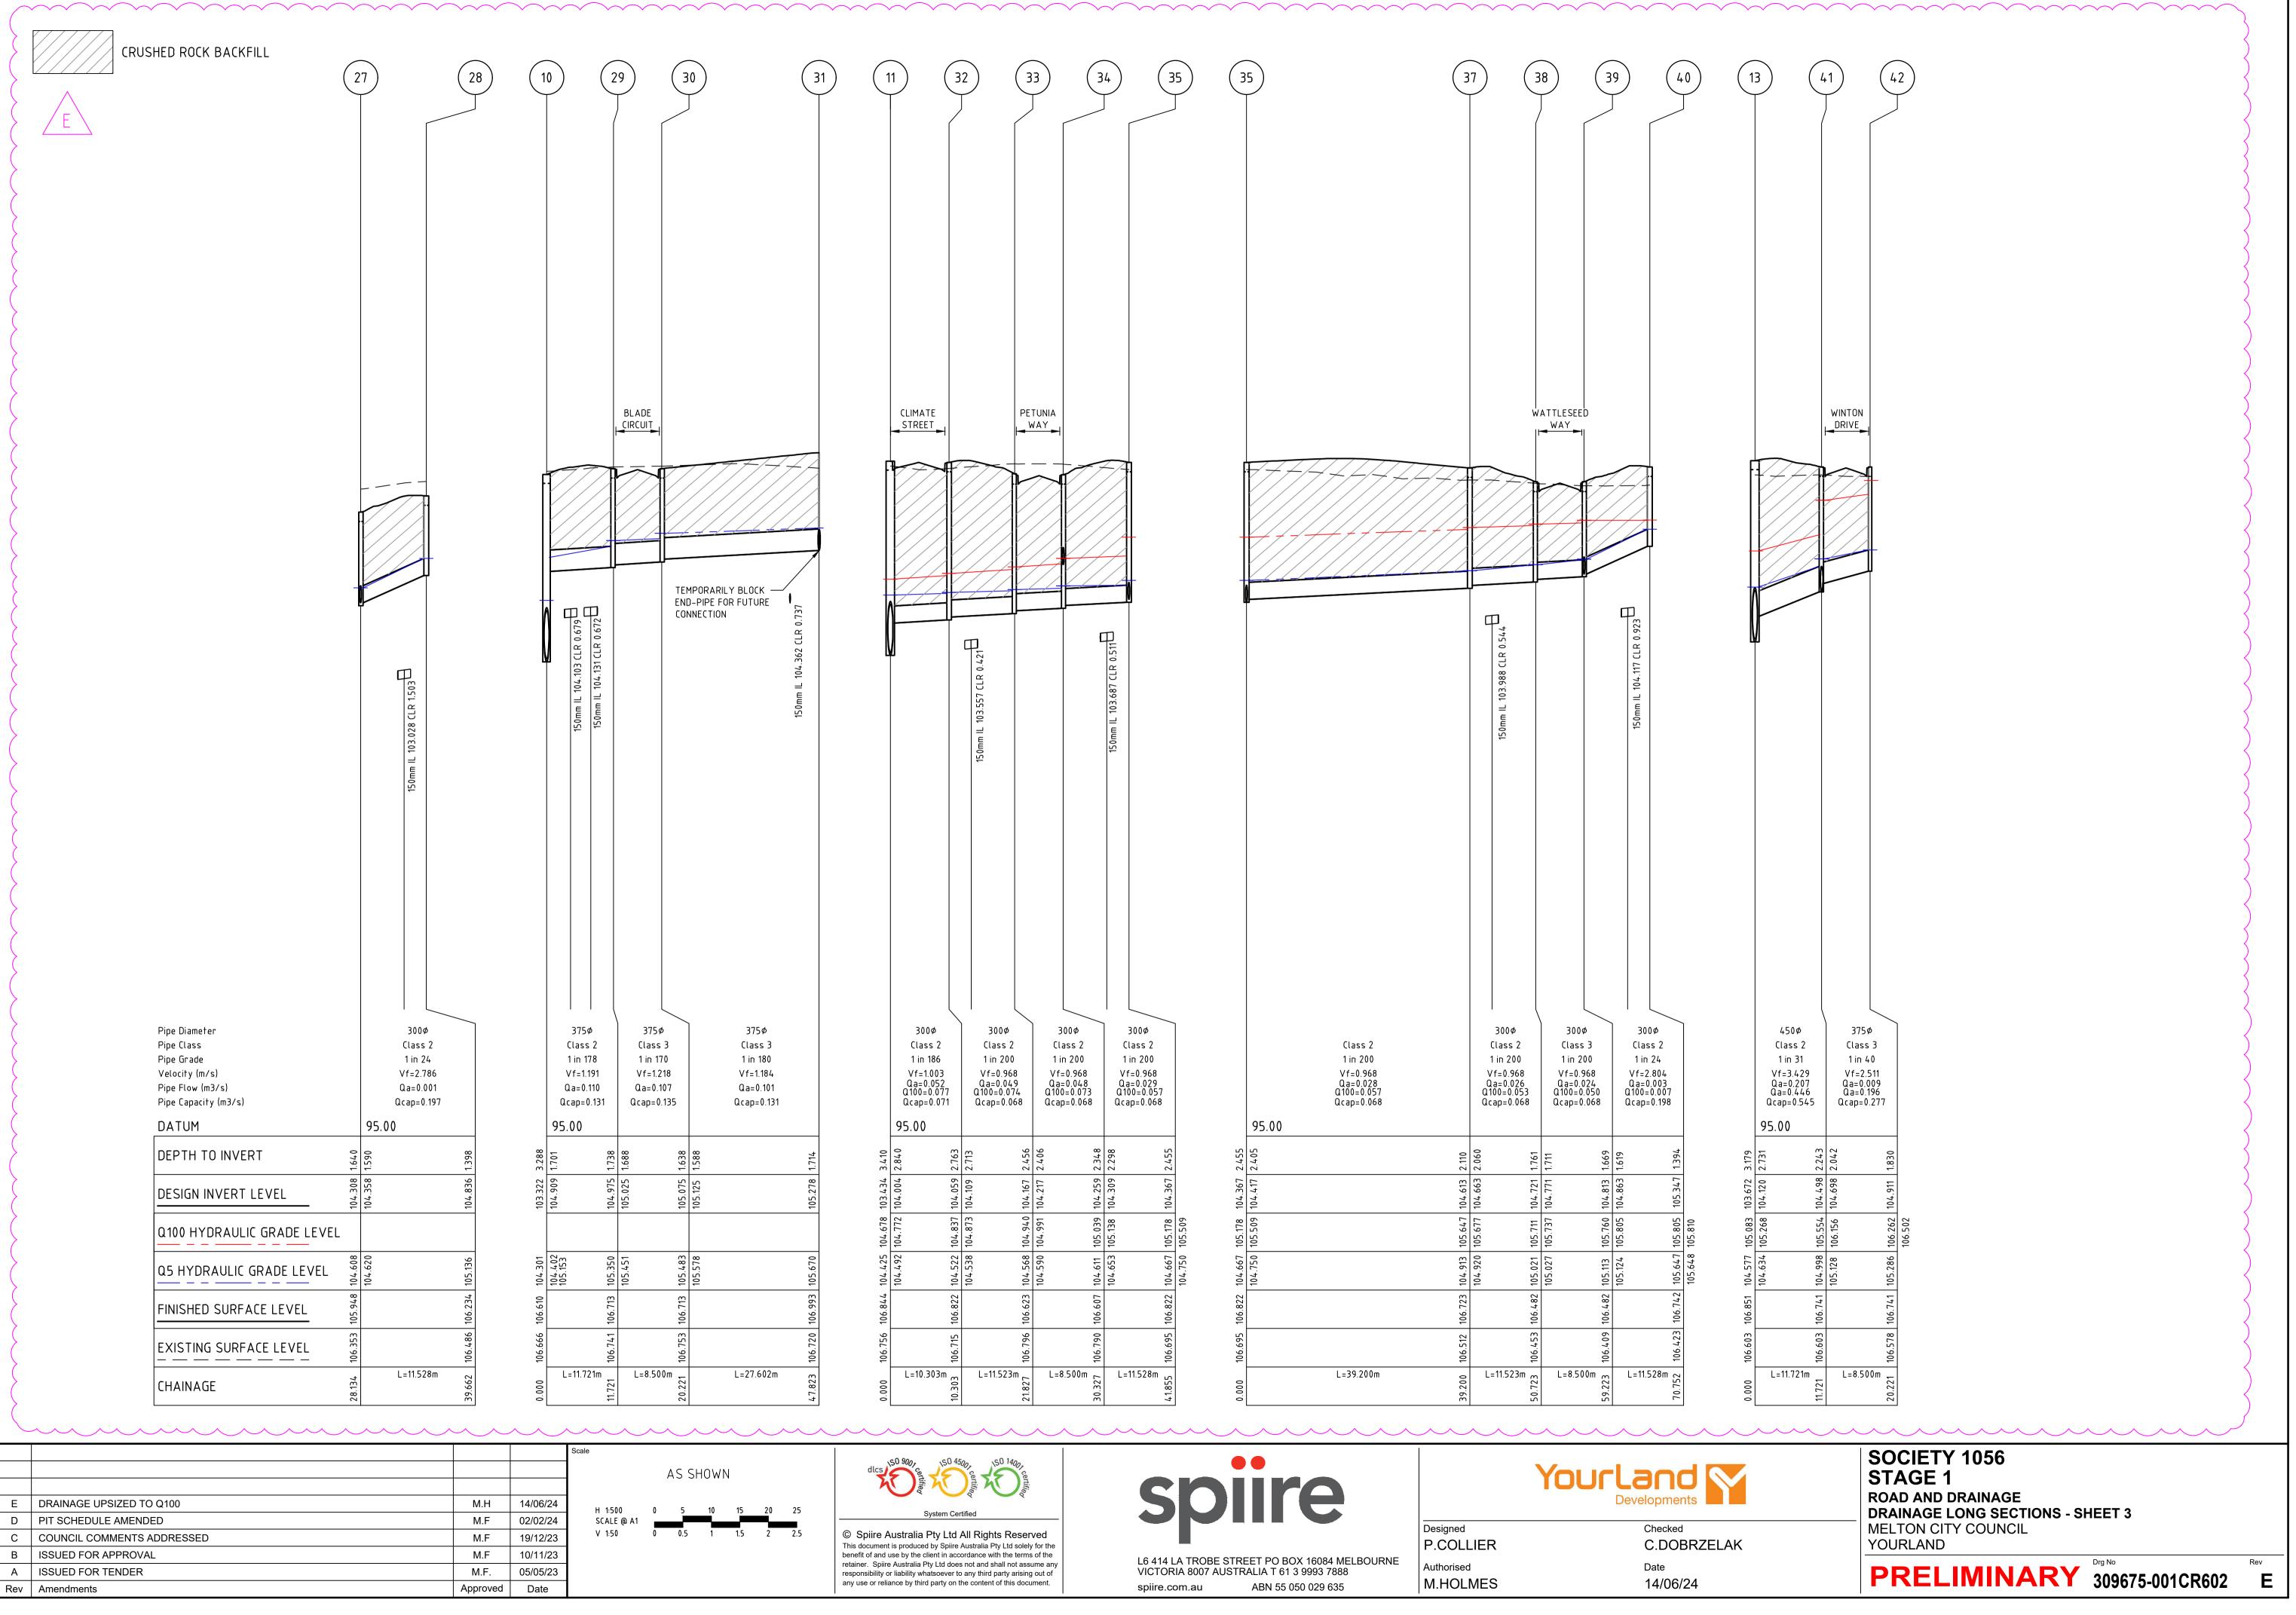

tted by Winnie 06/2024 3:591 Jq ≍ ن چ

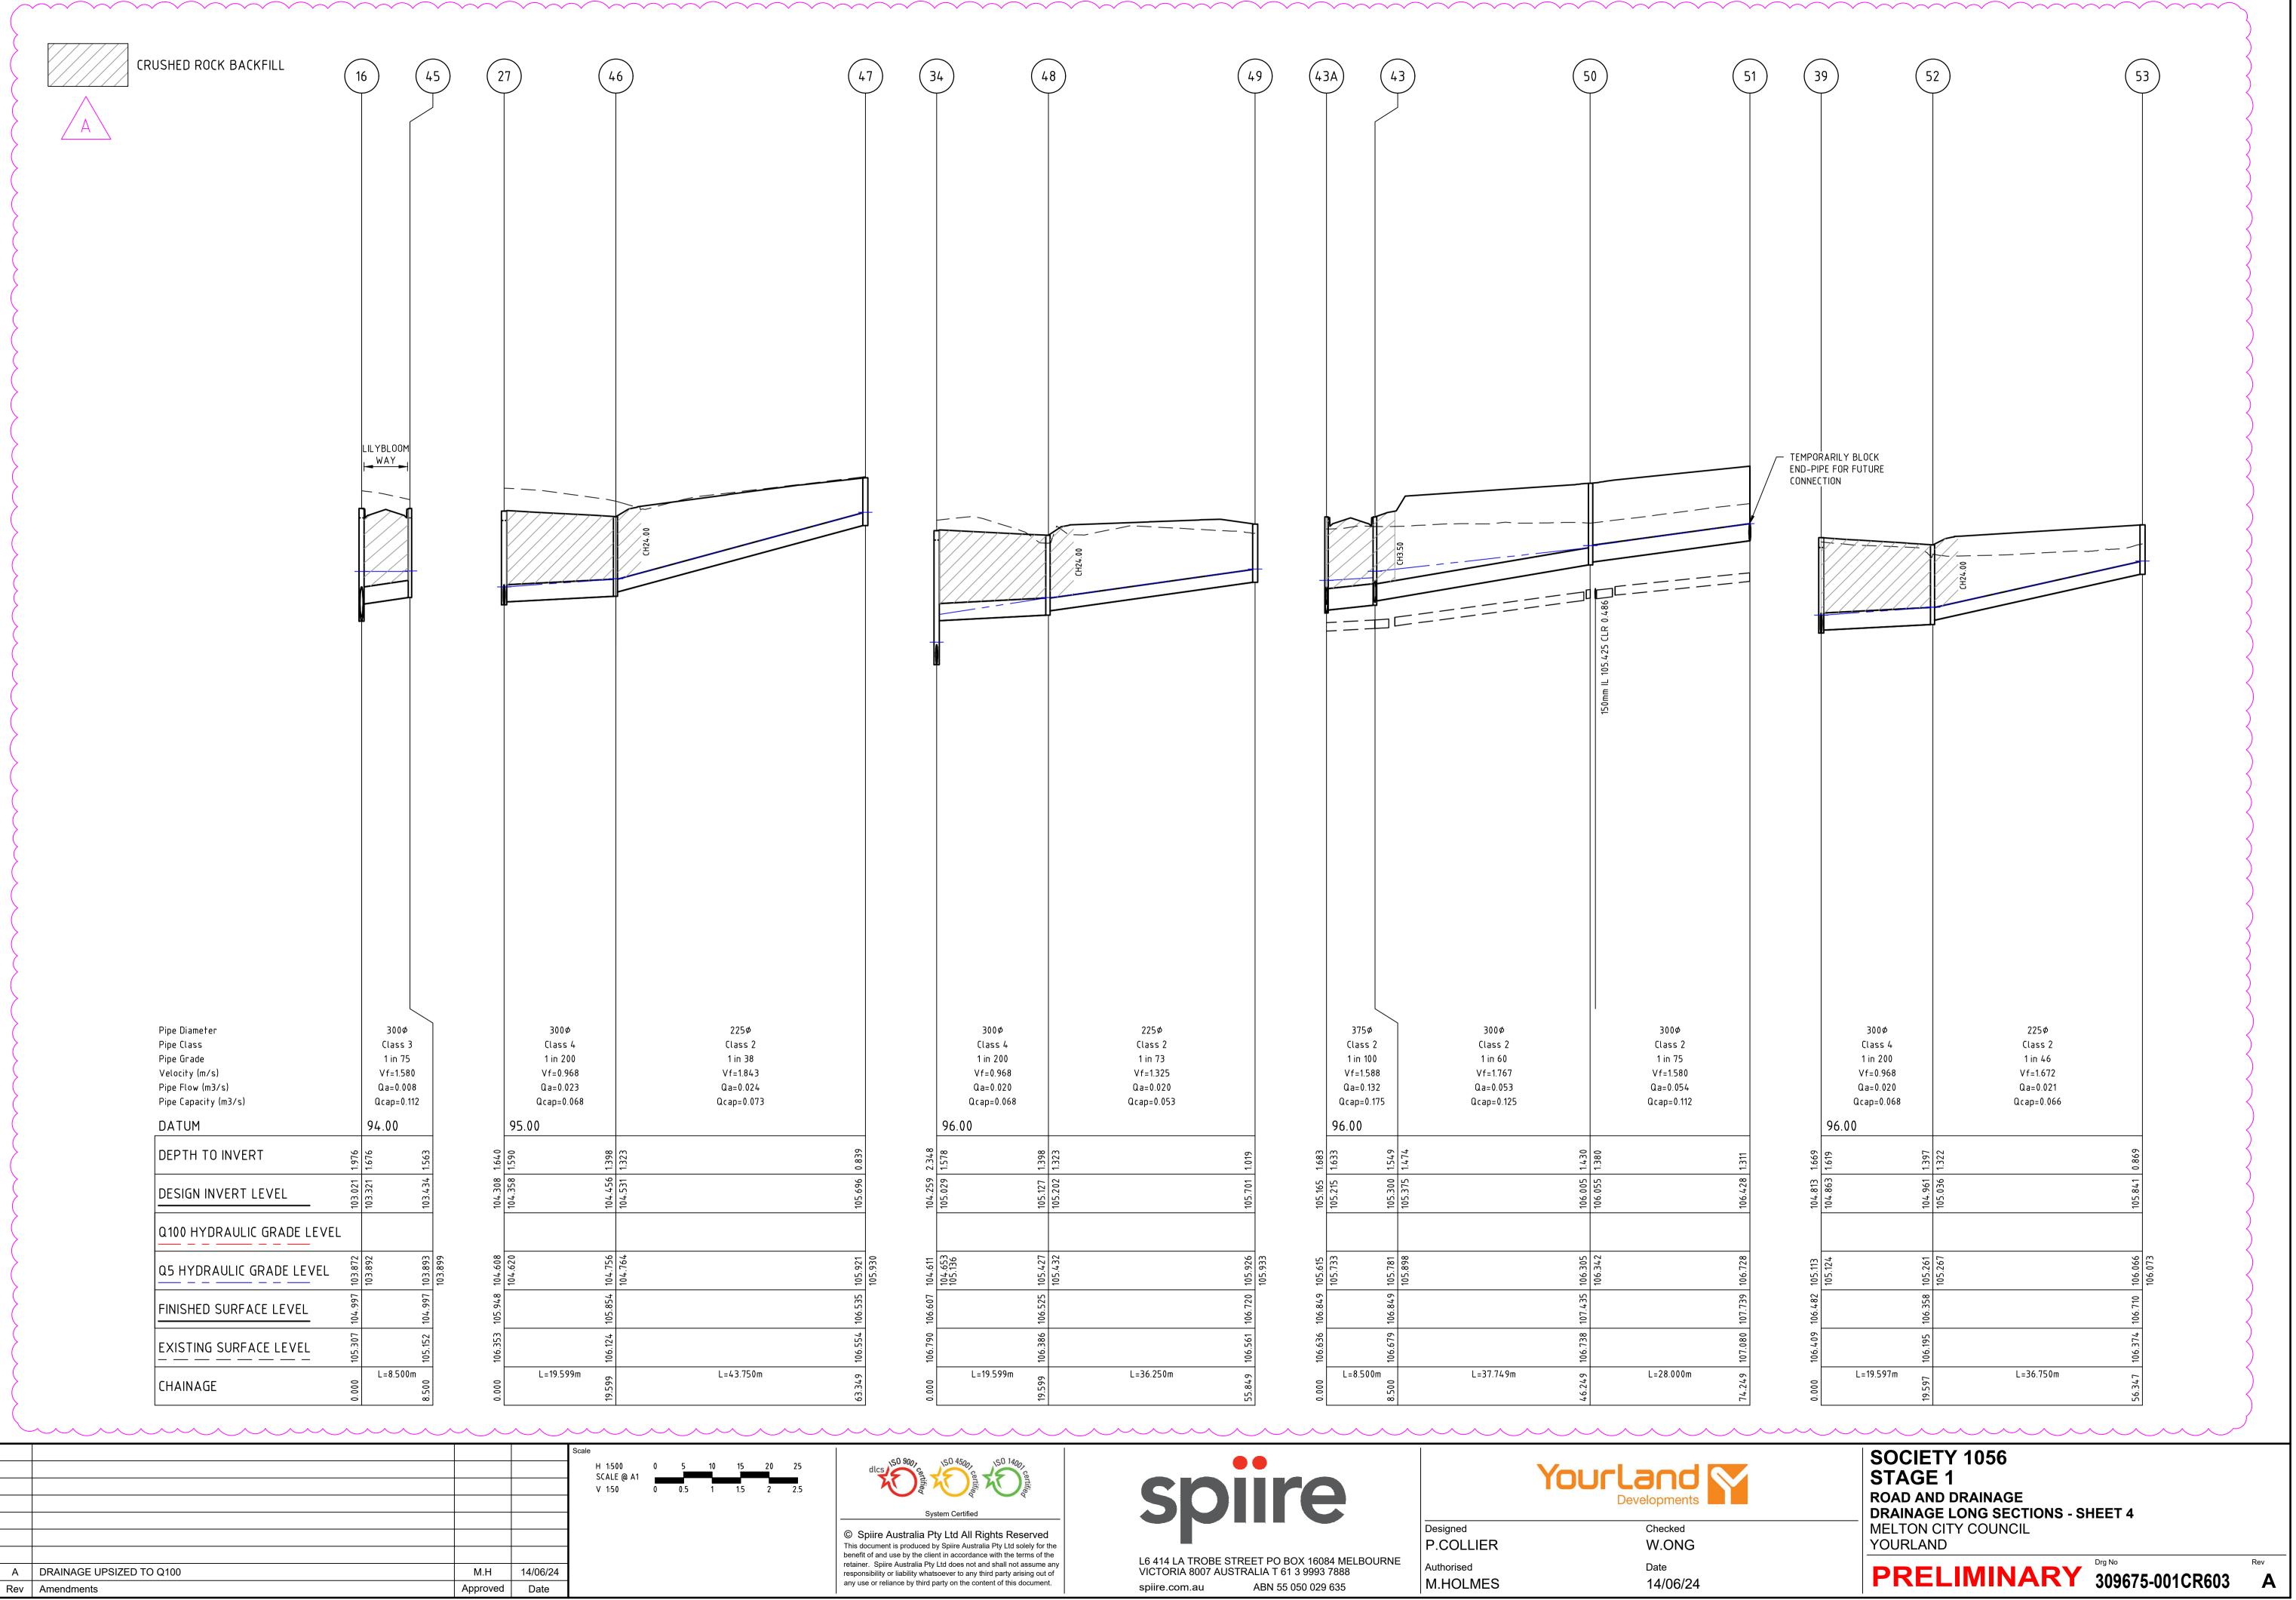

CRUSHED ROCK BACKFILL	41		(43A)		54	) (	43	
								+ +
								/_/_/
			0.328	TEMPORARILY BLOC END-PIPE FOR FUTU CONNECTION			0.311	
			104.844 CLR (				104.892 CLR	
			150mm IL 104				150mm IL 10	
Pipe Diameter Pipe Class Pipe Grade		450ø Class 4 1 in 35		300ø Class 2 1 in 70				375ø Class 4 1 in 200
Velocity (m/s) Pipe Flow (m3/s) Pipe Capacity (m3/s)		Vf=3.031 Qa=0.191 Qcap=0.482		Vf=1.636 Qa=0.061 Qcap=0.116				Vf=1.123 Qa=0.083 Qcap=0.124
DATUM		.00					96.00	
	498 2.192 548 2.192		165         1.683           315         1.533		/15 1.397		300 1.549 350 1.499	
Q100 HYDRAULIC GRADE LEVE			105.165 105.315		105.715		105.300	
Q5 HYDRAULIC GRADE LEVEL	8 8		105.615 105.733		106.015		105.781 105.898	
FINISHED SURFACE LEVEL	106.741 104 105.741 105		106.849 105. 105.		107.112 106.		106.84.9 105.	
EXISTING SURFACE LEVEL	106.603 106		106.636 106		106.808 107		106.679 106	
	$\Xi$		¥	L=28.001m	49.598 10		=	L=28.001m

plotted by CR604 name 3096

A DRAINAGE UPSIZED TO Q100

Rev Amendments


M.H 14/06/24 Approved Date

System Certified © Spiire Australia Pty Ltd All Rights Reserved This document is produced by Spiire Australia Pty Ltd solely for the benefit of and use by the client in accordance with the terms of the retainer. Spiire Australia Pty Ltd does not and shall not assume any responsibility or liability whatsoever to any third party arising out of any use or reliance by third party on the content of this document.

-	TEMPORARILY BLOCK
	END-PIPE FOR FUTURE
	CONNECTION

(44)

5
105 490
105 960
107 112
106 836
8 0 0 1

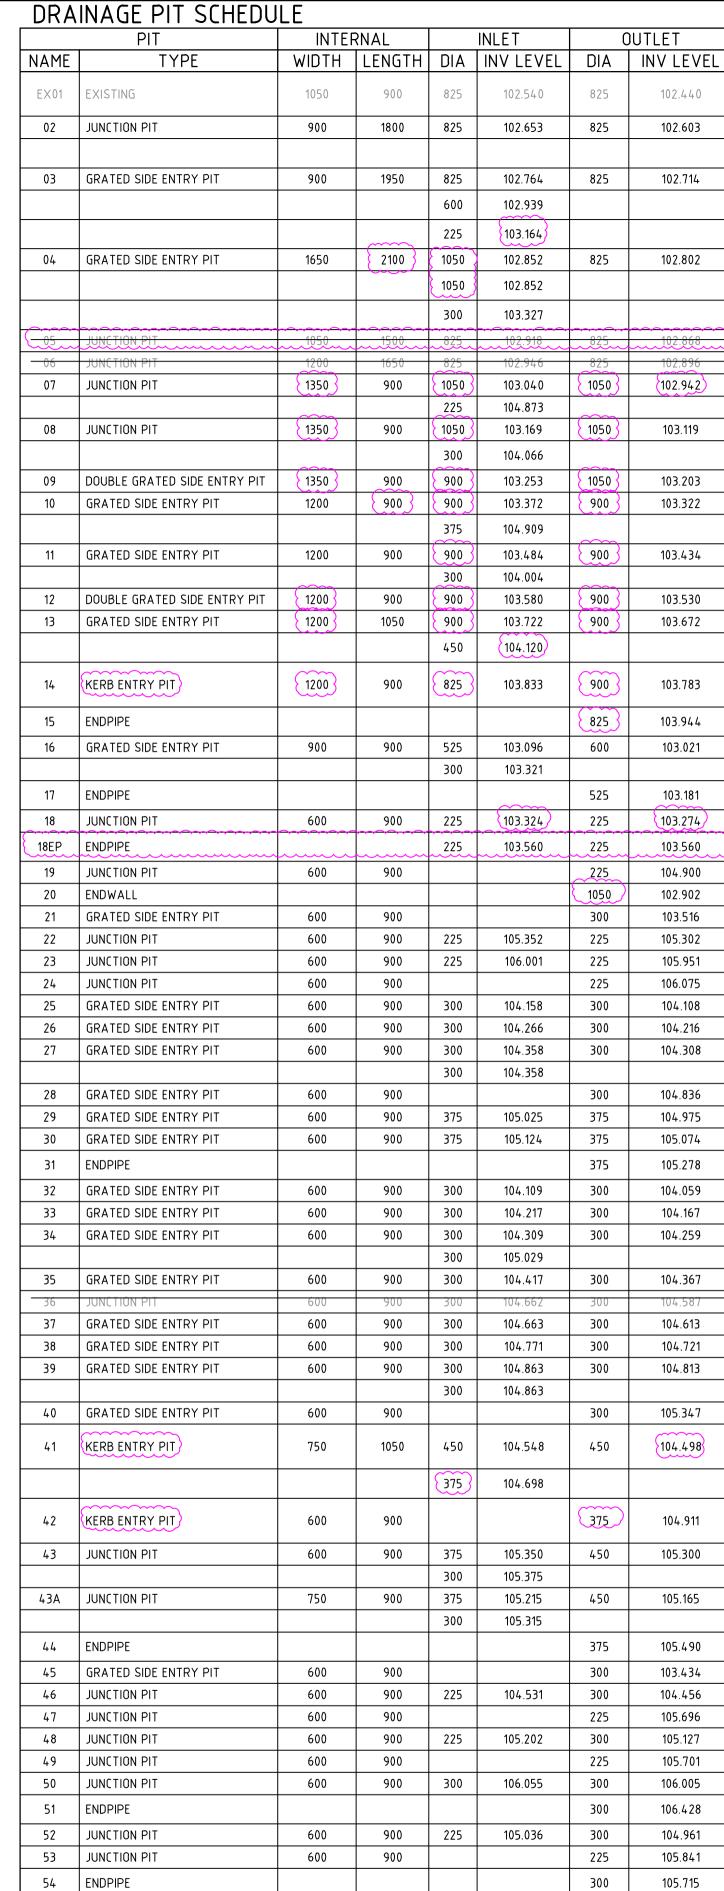



Designed P.COLLIER Authorised M.HOLMES



Checked W.ONG Date 14/06/24

L6 414 LA TROBE STREET PO BOX 16084 MELBOURNE VICTORIA 8007 AUSTRALIA T 61 3 9993 7888 spiire.com.au ABN 55 050 029 635

106.822	2.455	REFER TO GAA EDCM STD DWG DWG 601 & 605	
106.848	2.261	REFER TO GAA EDCM STD DWG DWG 605	
106.723	2.110	REFER TO GAA EDCM STD DWG DWG 601 & 605	
106.482	1.761	REFER TO GAA EDCM STD DWG DWG 601 & 605	
106.482	1.669	REFER TO GAA EDCM STD DWG DWG 601 & 605	
106.742	1.394	REFER TO GAA EDCM STD DWG DWG 601 & 605	
106.741	2.243	REFER TO GAA EDCM STD DWG DWG 607, INSTALL CIVIL MART KERB ENTRY UNIT "KER-03000D" AS PER MANUFACTURERS DETAIL	
		REFER TO VICROADS SD1023 FOR STRUCTURAL DETAILS	
106.741	1.830	REFER TO GAA EDCM STD DWG DWG 605, INSTALL CIVIL MART KERB ENTRY UNIT "KEL-03000D" AS PER MANUFACTURERS DETAIL	
106.849	1.549	REFER TO GAA EDCM STD DWG DWG 605	
106.849	1.684	REFER TO GAA EDCM STD DWG DWG 605	
107.112	1.622	BLANK OFF INLET WITH MARINE GRADE PLY BOARD FOR FUTURE CONNECTION	
104.997	1.563	REFER TO GAA EDCM STD DWG DWG 601 & 605	
105.854	1.398	REFER TO GAA EDCM STD DWG DWG 605	
106.535	0.839	REFER TO GAA EDCM STD DWG DWG 605	
106.525	1.398	REFER TO GAA EDCM STD DWG DWG 605	
106.720	1.019	REFER TO GAA EDCM STD DWG DWG 605	
107.430	1.425	REFER TO GAA EDCM STD DWG DWG 605	
107.739	1.311	BLANK OFF INLET WITH MARINE GRADE PLY BOARD FOR FUTURE CONNECTION	
106.358	1.397	REFER TO GAA EDCM STD DWG DWG 605	
106.710	0.869	REFER TO GAA EDCM STD DWG DWG 605	$\wedge$
107.112	1.397	BLANK OFF INLET WITH MARINE GRADE PLY BOARD	$\land \land$
		FOR FUTURE CONNECTION	
	ST ROA DRA MEL	OCIETY 1056 AGE 1 AD AND DRAINAGE AINAGE LONG SECTIONS & PIT SC TON CITY COUNCIL JRLAND	HEDULE - SHEET 5
			Rev
	<b>   </b>	RELIMINARY 3096	675-001CR604 A

+	PIT FS LEVEL	DEPTH	REMARKS
┥	104.821	2.381	EXISTING PIT, CONNECT TO EXISTING BLOCKOUT
+	104.820	2.218	REFER TO GAA EDCM STD DWG DWG 607 REFER TO VICROADS SD1023 FOR STRUCTURAL
			DETAILS
_	104.875	2.161	REFER TO GAA EDCM STD DWG DWG 601 & 607 REFER TO VICROADS SD1023 FOR STRUCTURAL
			DETAILS
		{	OUTLET AT IL 102.764
_	105.233	2.431	REFER TO GAA EDCM STD DWG DWG 601 & 607
			REFER TO VICROADS SD1023 FOR STRUCTURAL DETAILS
			SHAPE BASE TO PROVIDE SMOOTH FLOW THROUGH PIT TOWARDS DOWNSTREAM OUTLET
	105.385	2.517	REFER TO GAA EDCM STD DWG DWG 607
+	105.525	2.629	REFER TO GAA EDCM STD DWG DWG 607
╞	105.844	2.902	REFER TO GAA EDCM STD DWG DWG 607
╀	10(1/0)	2 0 2 0	
╀	106.148	3.029	REFER TO GAA EDCM STD DWG DWG 607
╞	(10( 002)		
╀	106.093	2.890	REFER TO GAA EDCM STD DWG DWG 602 & 607 REFER TO GAA EDCM STD DWG DWG 601 & 607
╀		J.200/	
╀	106 07 /	2 / 10	
╀	106.844	3.410	REFER TO GAA EDCM STD DWG DWG 601 & 607
╀	106.751	3.221	REFER TO GAA EDCM STD DWG DWG 602 & 607
╞	106.851	3.179	REFER TO GAA EDCM STD DWG DWG 601 & 607
t	/		REFER TO VICROADS SD1023 FOR STRUCTURAL
╀		$\sim$	REFER TO GAA EDCM STD DWG DWG 607, INSTALL
	106.632	2.849	CIVIL MART KERB ENTRY UNIT "KEC-03000D" AS PER
t	107.051	3.106	BLANK OFF INLET WITH MARINE GRADE PLY BOARD
╞	104.997	1,976	REFER TO GAA EDCM STD DWG DWG 601 & 607
t			
ſ	105.170	1.990	BLANK OFF INLET WITH MARINE GRADE PLY BOARD FOR FUTURE CONNECTION
t	104.726	1.452	REFER TO GAA EDCM STD DWG DWG 605
ſ	104.962	1.402	BLANK OFF INLET WITH MARINE GRADE PLY BOARD
F	105.745	0.845	REFER TO GAA EDCM STD DWG DWG 605
ţ			REFER TO CR900 FOR DETAILS
ſ	105.243	1.728	REFER TO GAA EDCM STD DWG DWG 601 & 605
╞	106.167	0.865	REFER TO GAA EDCM STD DWG DWG 605
╞	106.814	0.863	REFER TO GAA EDCM STD DWG DWG 605
╞	106.849	2.053	REFER TO GAA EDCM STD DWG DWG 605
╀	106.161	2.053	REFER TO GAA EDCM STD DWG DWG 601 & 605 REFER TO GAA EDCM STD DWG DWG 601 & 605
╞	105,948	1.640	REFER TO GAA EDCM STD DWG DWG 601 & 605
f			
Į	106.234	1.398	REFER TO GAA EDCM STD DWG DWG 601 & 605
Í	106.713	1.738	REFER TO GAA EDCM STD DWG DWG 601 & 605
┞	106.713	1.638	REFER TO GAA EDCM STD DWG DWG 601 & 605 BLANK OFF INLET WITH MARINE GRADE PLY BOARD
	106.992	1.714	FOR FUTURE CONNECTION
┞	106.822	2.763	REFER TO GAA EDCM STD DWG DWG 601 & 605
╞	106.623	2.456	REFER TO GAA EDCM STD DWG DWG 601 & 605
╞	106.607	2.348	REFER TO GAA EDCM STD DWG DWG 601 & 605
╞	106.822	2.455	REFER TO GAA EDCM STD DWG DWG 601 & 605
╞	106.848	2.261	REFER TO GAA EDCM STD DWG DWG 605
ļ	106.723	2.110	REFER TO GAA EDCM STD DWG DWG 601 & 605
ĺ	106.482	1.761	REFER TO GAA EDCM STD DWG DWG 601 & 605
	106.482	1.669	REFER TO GAA EDCM STD DWG DWG 601 & 605
┞	106 7/ 2	1 207	REFER TO GAA EDCM STD DWG DWG 601 & 605
╞	106.742	1.394	REFER TO GAA EDLM STD DWG DWG 601 & 605 REFER TO GAA EDCM STD DWG DWG 607, INSTALL
	106.741	2.243	CIVIL MART KERB ENTRY UNIT "KER-03000D" AS PER
╞			MANUFACTURERS DETAIL REFER TO VICROADS SD1023 FOR STRUCTURAL
┞			DETAILS REFER TO GAA EDCM STD DWG DWG 605, INSTALL
	106.741	1.830	CIVIL MART KERB ENTRY UNIT "KEL-03000D" AS PER MANUFACTURERS DETAIL
╞	106.849	1.549	REFER TO GAA EDCM STD DWG DWG 605
ſ			
ſ	106.849	1.684	REFER TO GAA EDCM STD DWG DWG 605
L			

## DESIGN PAVEMENT PROFILE

PAVEMENT LAYER	DESCRIPTION	DEPTH (mm) TYPE A [×]
ASPHALT UPPER LAYER	SIZE 10 mm TYPE N (CLASS 320 BINDER)	30
ASPHALT LOWER LAYER	SIZE 10 mm TYPE N (CLASS 320 BINDER)	30
SAMI	SIZE 10 S18R	Y
PRIME / PRIMER SEAL	BITUMEN PRIME OR BITUMEN EMULSION PRIMER OR SIZE 7 mm BITUMEN EMULSION PRIMER SEAL	Y
BASE	SIZE 20 mm CLASS 2 CRUSHED ROCK OR SIZE 20 mm CLASS 2 CRUSHED RECYCLED CONCRETE	130
SUB BASE	SIZE 20 mm CLASS 3 CRUSHED ROCK OR SIZE 20 mm CLASS 3 CRUSHED RECYCLED CONCRETE	100
CAPPING LAYER	APPROVED LOW PERMEABILITY SELECT MATERIAL MAXIMUM PERMEABILITY 5 X 10-9 m/s, MINIMUM SOAKED CBR 8%, MAX CBR SWELL 1.5%.	150
CONSTRUCTION LAYER	APPROVED LOW PERMEABILITY SELECT MATERIAL MAXIMUM PERMEABILITY 5 X 10-9 m/s, MINIMUM SOAKED CBR 8%, MAX CBR SWELL 1.5%.	150
SUBGRADE	PREPARED IN ACCORDANCE WITH EDCM-2019	
	TOTAL PAVEMENT DEPTH	590

* REFER PAVEMENT PLAN FOR LOCATION OF PAVEMENT TYPES

## PAVEMENT DETAILS

THE PAVEMENT DESIGNS SHOWN HERE HAVE BEEN DESIGNED/PROVIDED BY DOUGLAS PARTNERS WHO ARE RESPONSIBLE FOR THE GEOTECHNICAL WORK ON THIS PROJECT. SPIIRE IS NOT RESPONSIBLE FOR THE WORK OF DOUGLAS PARTNERS.

THE DESIGN HAS BEEN EXTRACTED FROM THE REPORT ON GEOTECHNICAL INVESTIGATION AND ADVICE RESIDENTIAL SUB-DIVISION REPORT ON "GEOTECHNICAL INVESTIGATION FOR 1056 TAYLORS ROAD" THIS DOCUMENT SHOULD BE REVIEWED TO ENSURE THAT THE DESIGN HAS BEEN ACCURATELY REPRODUCED.


A COPY OF THE DOCUMENT WILL BE PROVIDED ON REQUEST.

SPIIRE DOES NOT ACCEPT ANY RESPONSIBILITY FOR THE ACCURACY, ADEQUACY OR APPROPRIATENESS OF THE GEOTECHNICAL WORK AND PAVEMENT DESIGNS. ANY QUERIES IN RESPECT TO THE GEOTECHNICAL WORK AND PAVEMENT DESIGNS SHOULD BE ADDRESSED TO DOUGLAS PARTNERS AND COPIED TO SPIIRE.


ROAD NAME	TYPE
CLIMATE STREET	А
WINTON DRIVE	А
BLADE CIRCUIT	А
LILYBLOOM WAY	А
GINKGO STREET	А
PETUNIA WAY	А
WATTLESEED DRIVE	A
	CLIMATE STREET WINTON DRIVE BLADE CIRCUIT LILYBLOOM WAY GINKGO STREET PETUNIA WAY

CONCRETE PAVEMENT NOTES:

- 1. ALL WORKS TO BE COMPLETED IN ACCORDANCE WITH RELEVANT AUSTRALIAN STANDARDS AND CCAA LITERATURE; OR VIC ROADS STANDARDS FOR NON RESIDENTIAL STREETS.
- 2. ALL CONCRETE TO BE MINIMUM 32MPa COMPRESSIVE STRENGTH
- 3. CONCRETE TO BE THOROUGHLY COMPACTED USING EITHER SURFACE AND/OR IMMERSION VIBRATORS, PARTICULARLY AROUND REINFORCEMENT AND IN CORNERS OF FORMS.
- 4. PRIOR TO CASTING, THE UNBOUND GRANULAR SUBBASE MUST BE DAMP TO ENSURE NO EARLY "DRYING OUT" OF THE CONCRETE.
- 5. CURING OF CONCRETE IS ESSENTIAL IDEALLY BY MAINTAINING WET HESSIAN OR SEALING WITH PLASTIC SHEETING.
- 6. SAW CUTTING OF CONCRETE SHOULD BE COMMENCED AS SOON AS CONCRETE PERMITS BY EXPERIENCED CONTRACTORS, BUT NO LATER THAN 12 HOURS AFTER POUR.
- 7. ALL DOWELS TO BE GRADE 250R STEEL BARS, 450mm LONG AND PLACED AT 300mm CENTRES. REFER CCAA- "CONCRETE PAVEMENT DESIGN FOR RESIDENTIAL STREETS" FOR DOWEL DIAMETERS. DOWELS MUST BE ACCURATELY PLACED TO ENSURE THE JOINT DOES NOT "LOCK". INSERTION OF DOWELS DURING THE PLACING OF CONCRETE IS NOT ACCEPTABLE. DOWELS MUST BE SAWN AND NOT CROPPED.
- 8. ALL JOINTS TO BE APPROPRIATELY SEALED TO RESIST THE INTRUSION OF SAND AND GRAVEL AND TO MINIMISE THE INGRESS OF WATER.

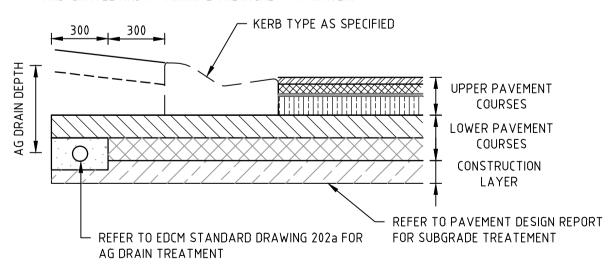


TYPICAL SUBSURFACE DRAINAGE DETAIL

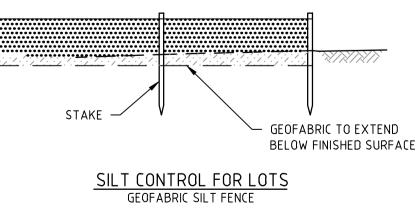


file


				Scale	
				AS SHOWN	
D	CONCRETE PAVEMENT REMOVED, ROAD NAME CHANGE	M.F	02/02/24		
С	COUNCIL COMMENTS ADDRESSED	M.F	19/12/23		© Tł
В	ISSUED FOR APPROVAL	M.F	10/11/23		be
А	ISSUED FOR TENDER	M.F.	05/05/23		re re
Rev	Amendments	Approved	Date		an

 $\Theta$ 

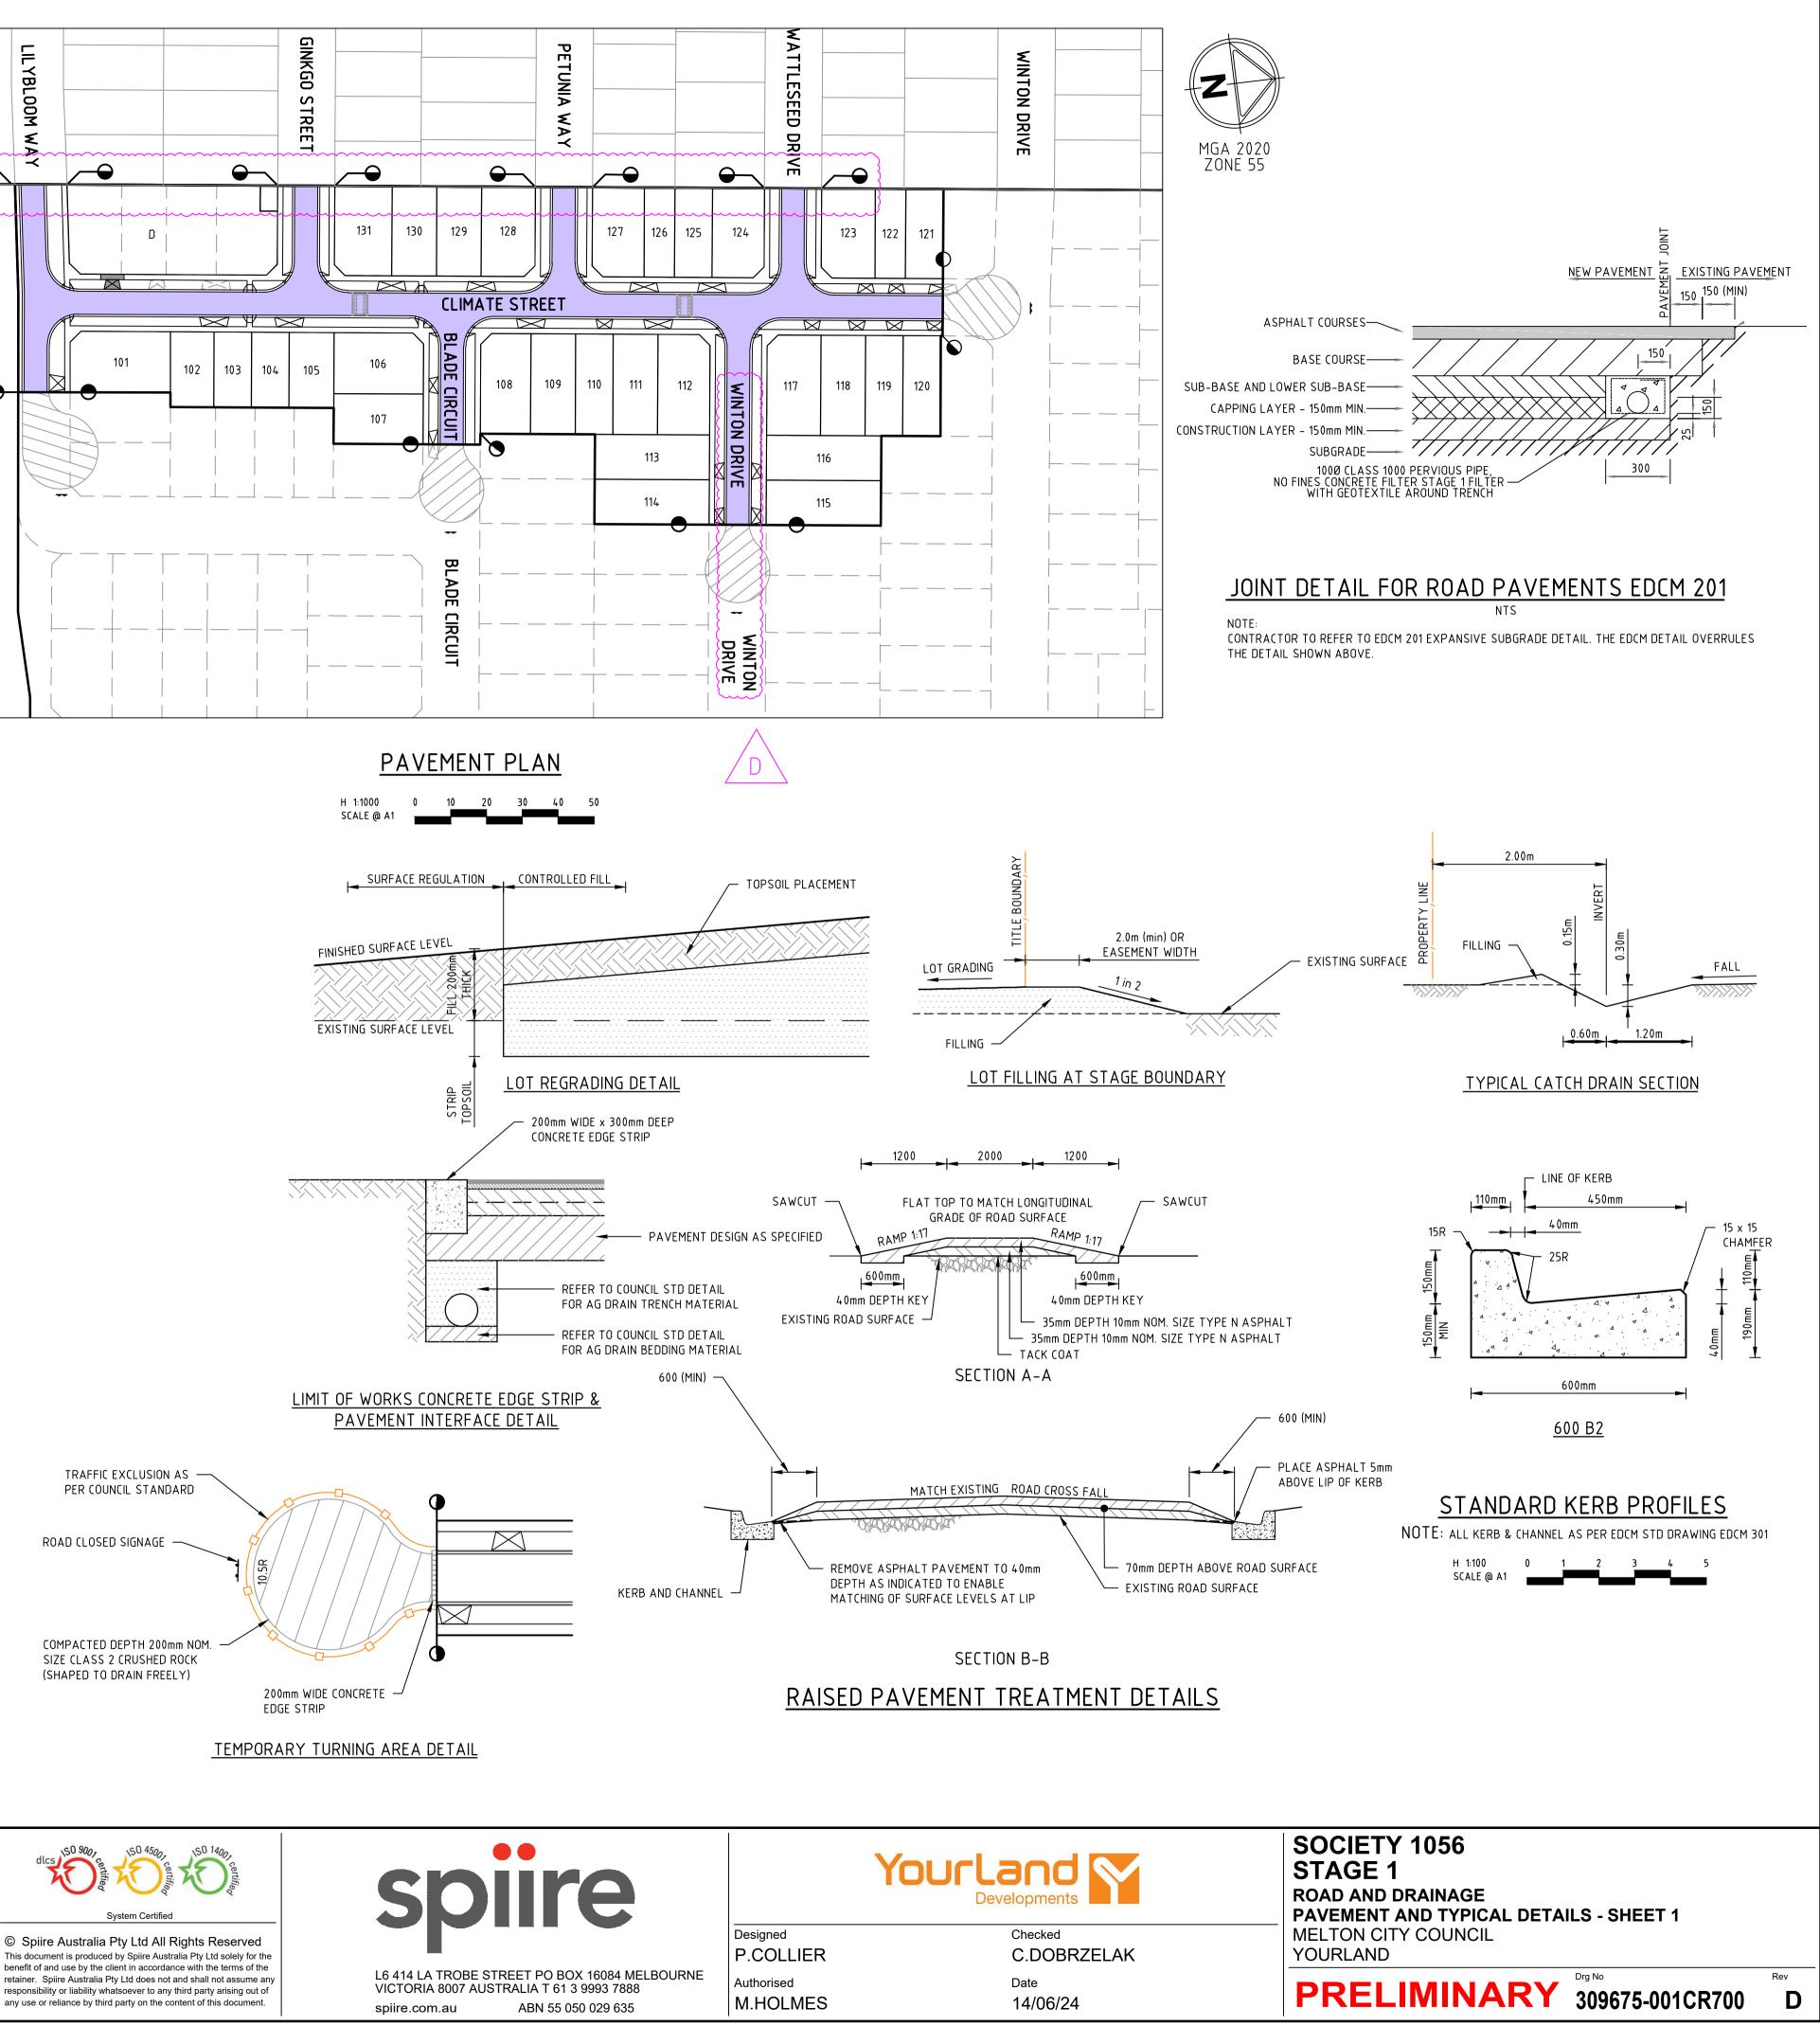

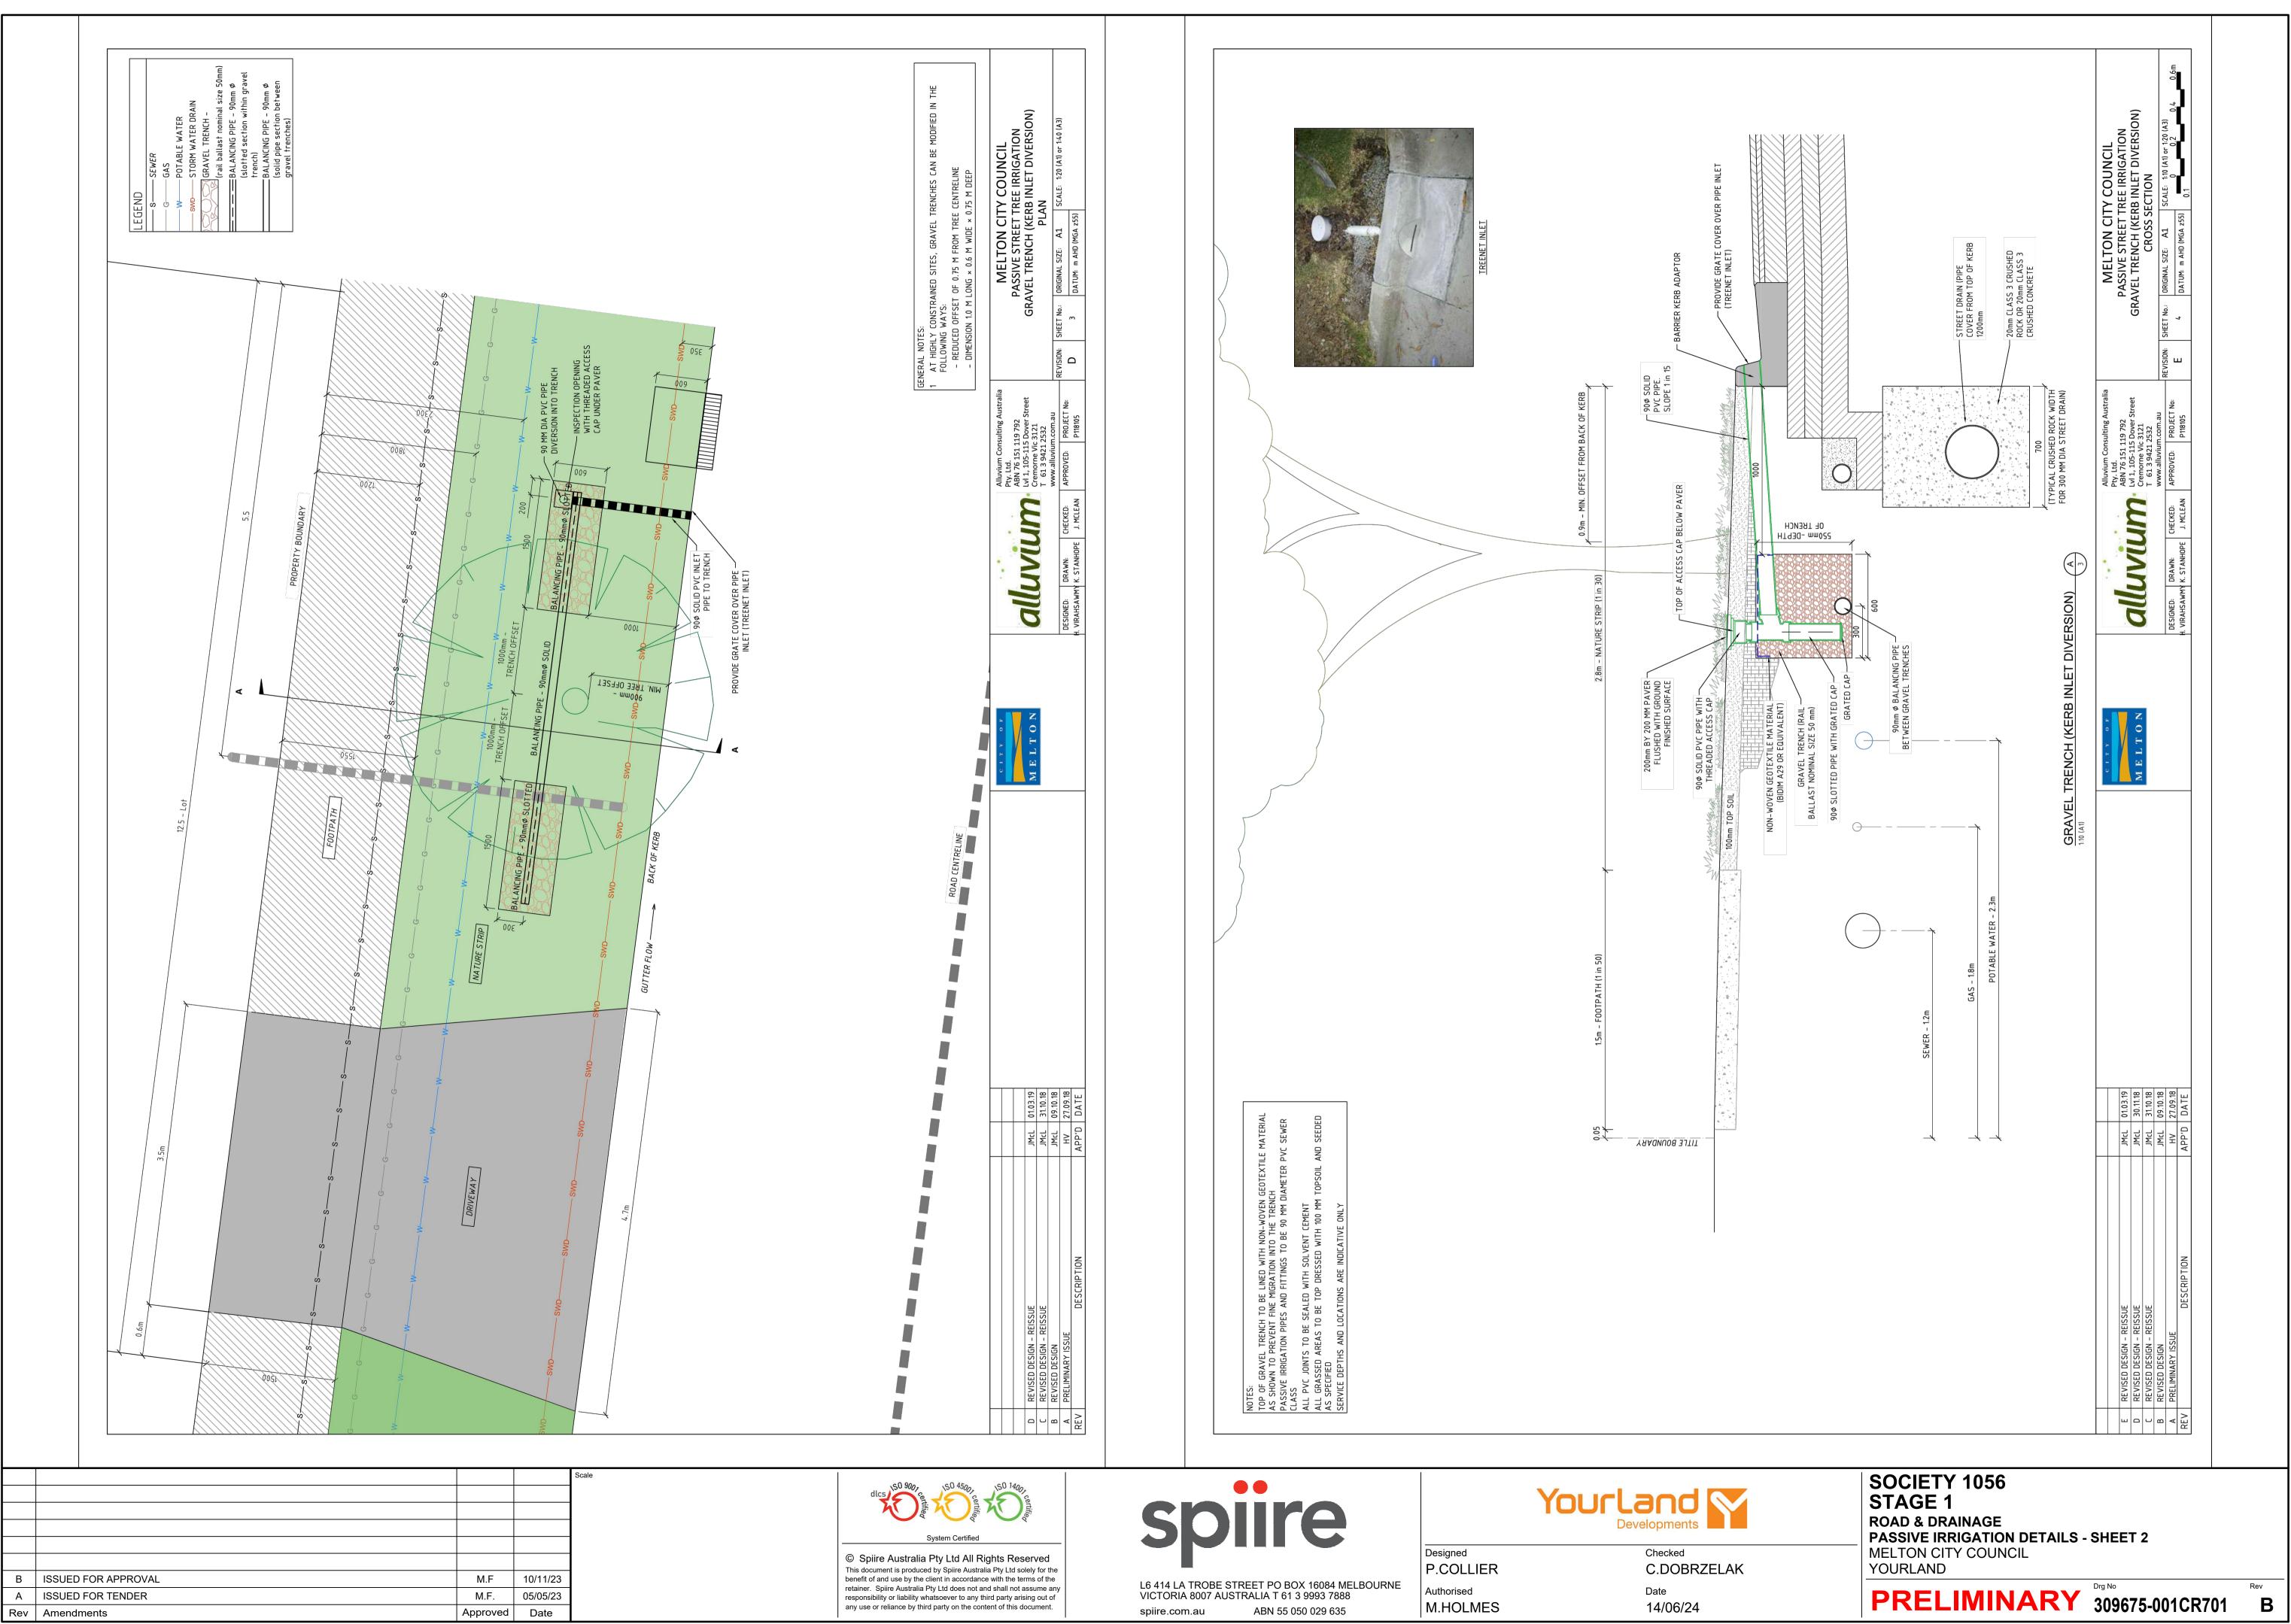

01CR 80

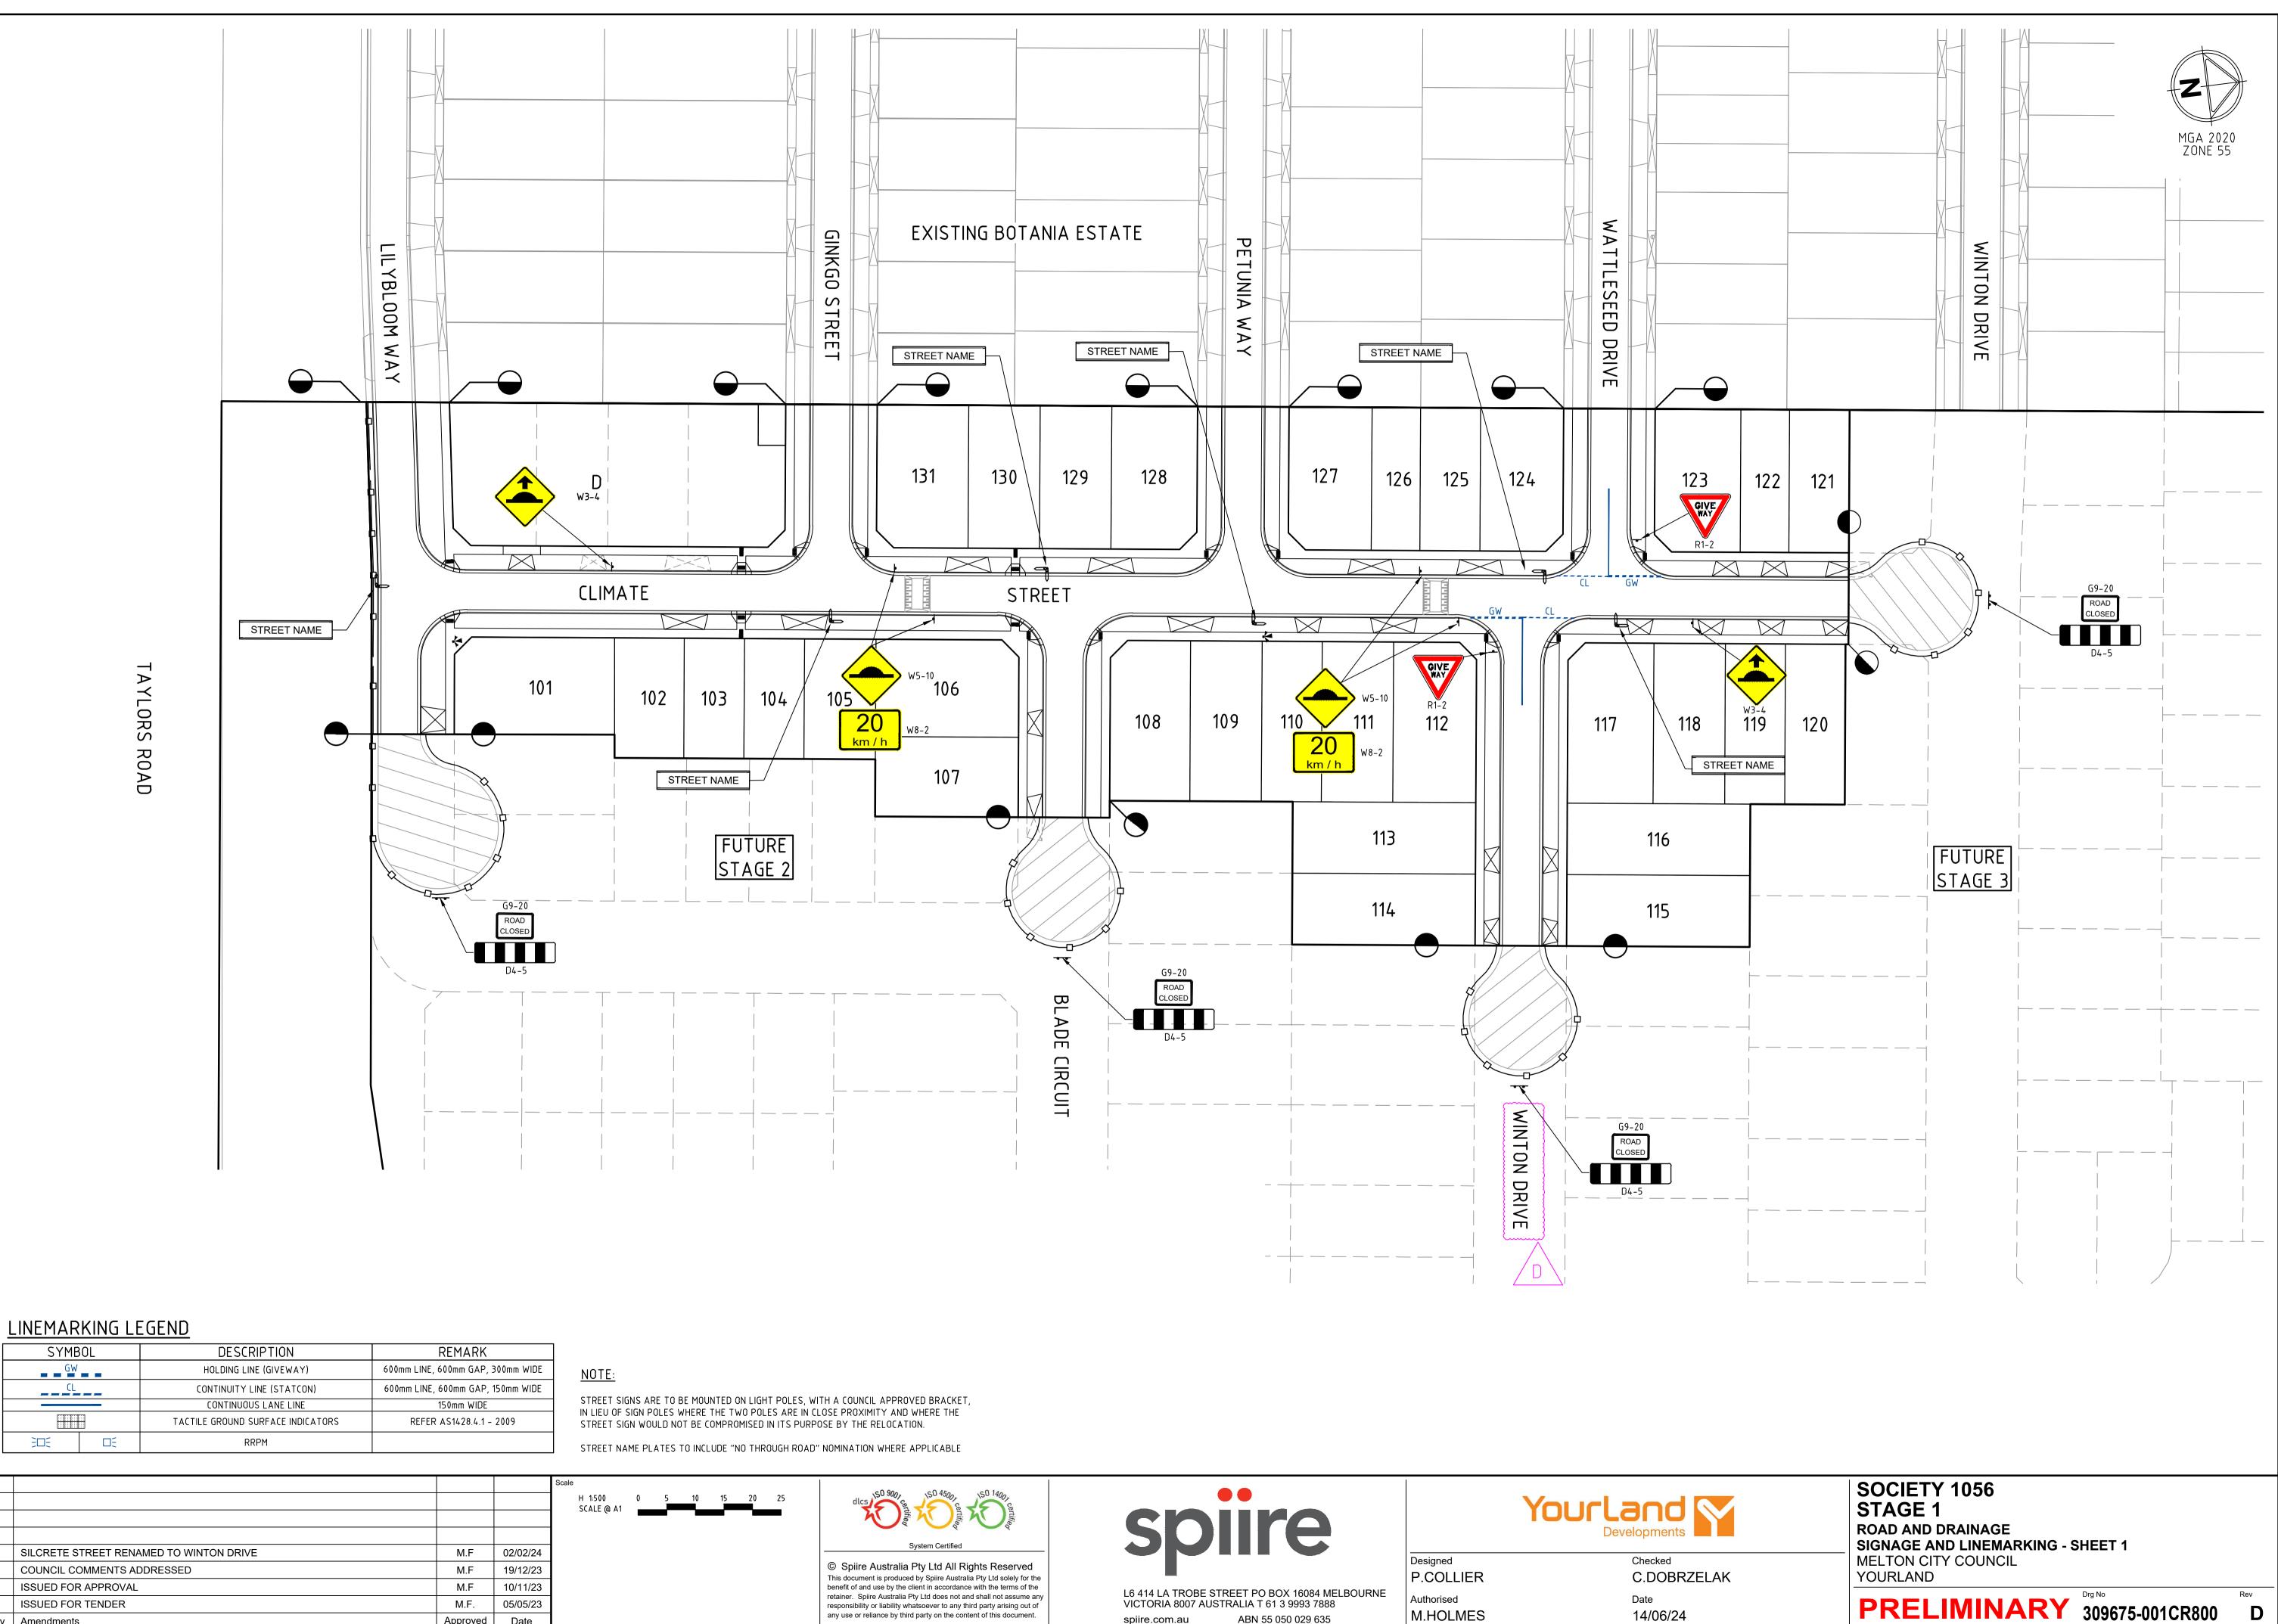

Syme	30L	DESCRIPTION	REMARK
GW		HOLDING LINE (GIVEWAY)	600mm LINE, 600mm GAP, 300mm WIDE
CL		CONTINUITY LINE (STATCON)	600mm LINE, 600mm GAP, 150mm WIDE
		CONTINUOUS LANE LINE	150mm WIDE
		TACTILE GROUND SURFACE INDICATORS	REFER AS1428.4.1 - 2009
303		RRPM	


D SILCRETE STREET RENAMED TO WINTON DRIVE COUNCIL COMMENTS ADDRESSED B ISSUED FOR APPROVAL A ISSUED FOR TENDER Approved Date Rev Amendments


С





spiire.com.au ABN 55 050 029 635 M.HOLMES

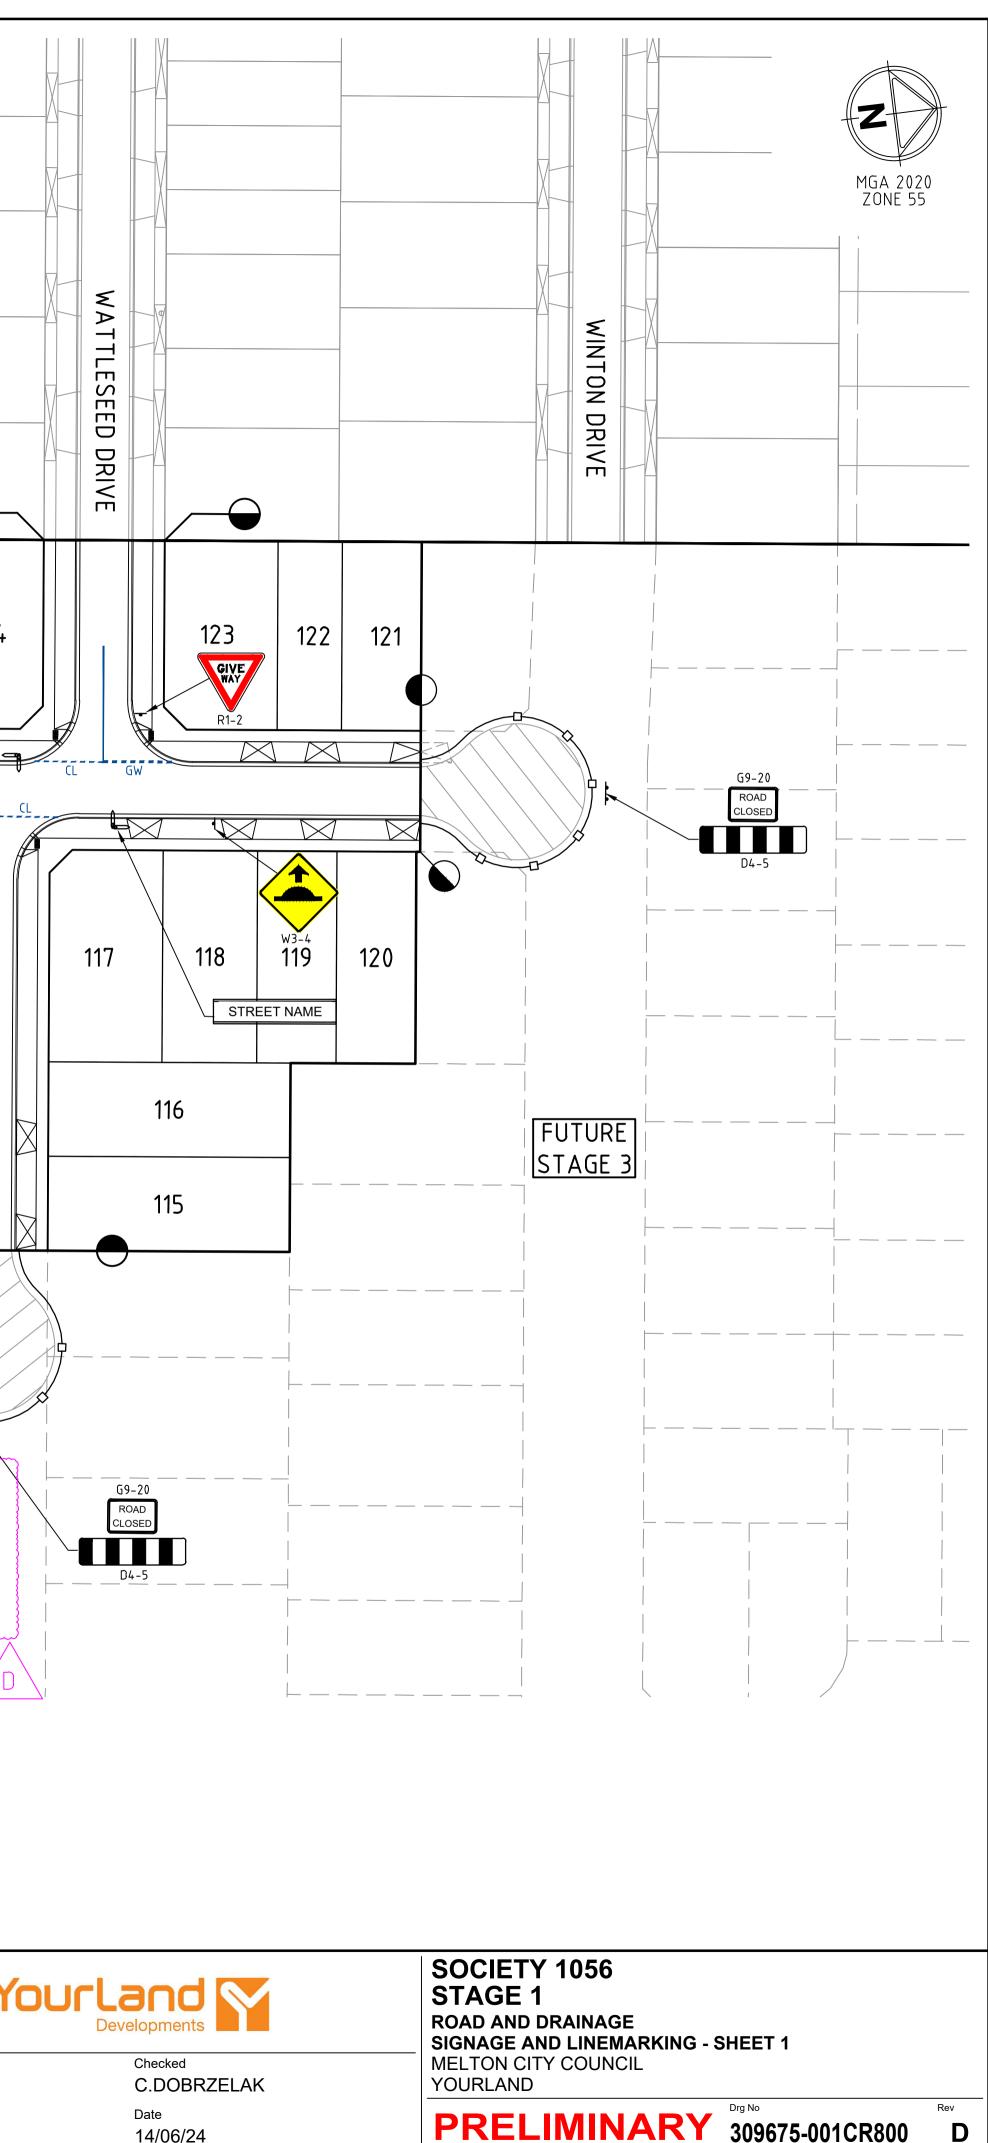

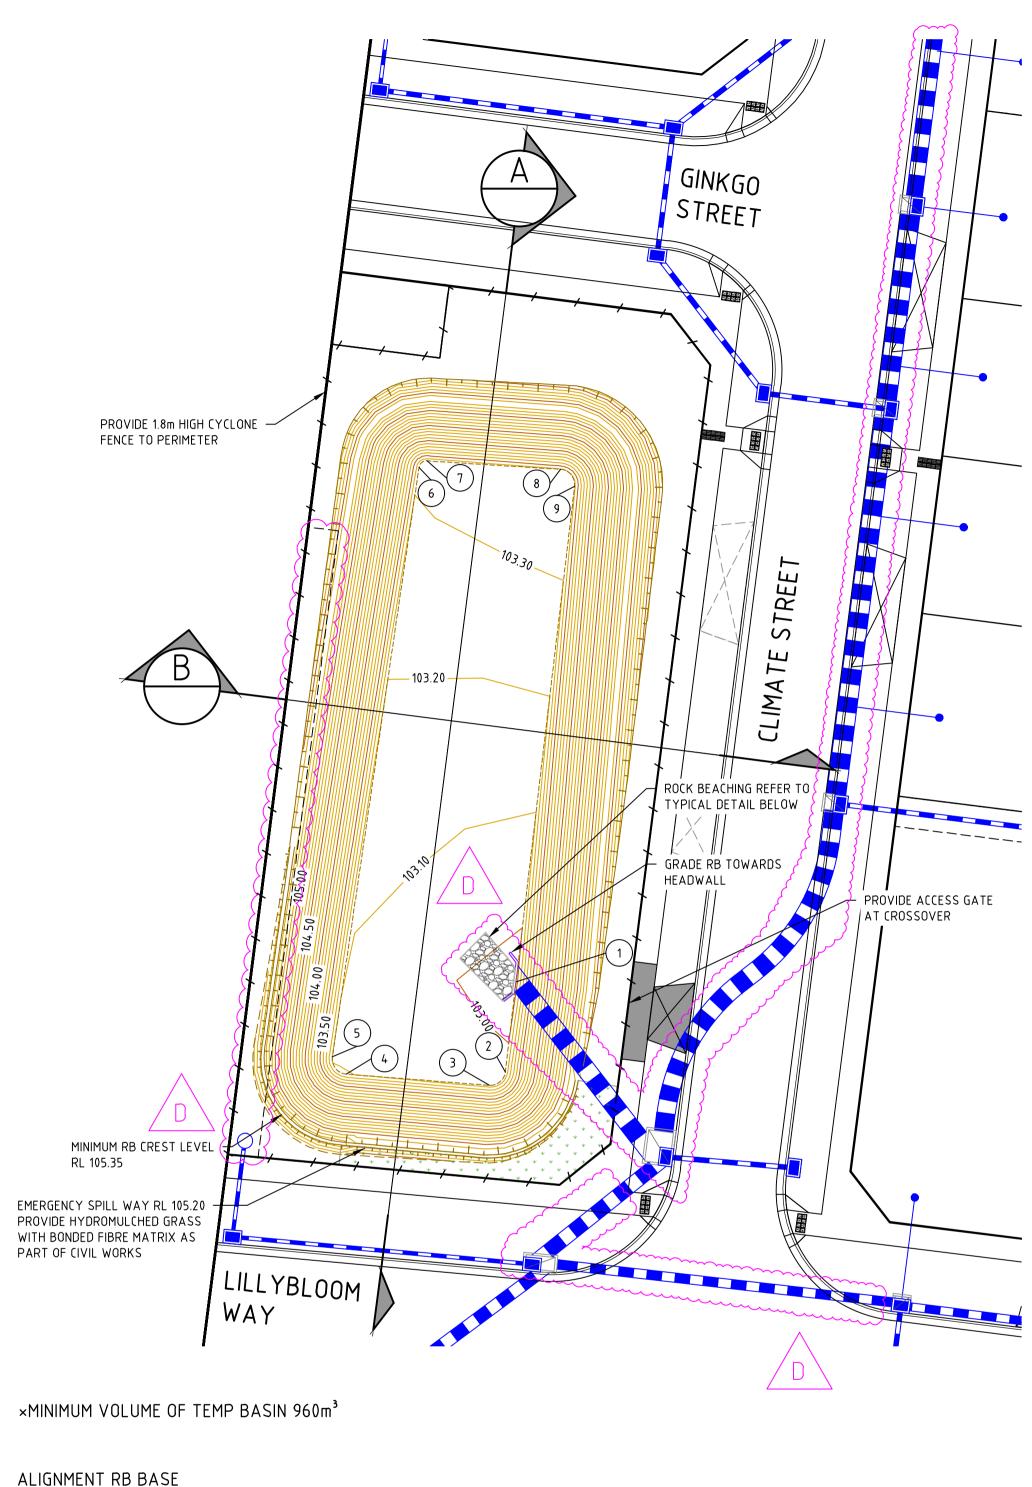

/ . E . G		ND DINGE
POINT	NO	EASTING
1		207/6/ 6/9

POINT NO 1 2 3 4 5 6 7 8 9	E A S T I N G 2 9 7 4 6 4 . 6 4 8 2 9 7 4 6 3 . 9 4 4 2 9 7 4 6 2 . 9 0 1 2 9 7 4 5 3 . 4 1 5 2 9 7 4 5 2 . 5 0 4 2 9 7 4 5 8 . 2 3 5 2 9 7 4 5 8 . 7 6 1 2 9 7 4 6 7 . 6 0 0 2 9 7 4 6 8 . 5 3 0	$\begin{array}{cccccccccccccccccccccccccccccccccccc$	2       1       0       3       .       0       2       4         1       1       0       3       .       0       4       2         3       1       0       3       .       1       0       3         5       1       0       3       .       1       0       3         5       1       0       3       .       3       2       1         6       1       0       3       .       3       2       1         0       1       0       3       .       3       3       0         1       0       3       .       3       8       8	
C U R V E 2 – 3 4 – 5 6 – 7	RADIUS       ARC         1.000       1.5         1.000       1.6         0.500       0.7	0 3 1 . 3 6 6 3 9 1 . 4 6 1	MID ORD 0.269 0.317 0.132	Q T R O R D 0.070 0.083 0.034


1.000 1.626 1.452 0.313 0.081

AC						
ואו					Scale	
01/0					NOT TO SCALE	
0\د/						
0.60						
30/3	D	DRAINAGE UPSIZED TO Q100	M.H	14/06/24		
;- /:0	С	RB AMENDED	M.F	02/02/24		() T
tion		ISSUED FOR APPROVAL	M.F	10/11/23		b
oca.	А	ISSUED FOR TENDER	M.F.	05/05/23		re re
file	Rev	Amendments	Approved	Date		a

8 - 9

		[		1.8m HIGH CYC N LOT BOUNDAI		$\wedge$		- PROVIDE 1.8m HIGH FENCE ON LOT BOU
							7	
			<u> </u>	- FULL S	TORAGE LEVEL	RL 104.75		
DATUM RL 101.0								
FINISHED SURFACE	105.534	105.561	188		103.168	105.959	105.998	105.875
EXISTING SURFACE		105.555	105 619		105.703	105.715	105.720	105.784
CHAINAGE	0.000	1.515	6 456		17.287	23.062	25.000	33.000
SECTION B		<i>,</i>		1.8m HIGH CYC N LOT BOUNDAI				
								~
				1.2				
DATUM RL 101.0								
FINISHED SURFACE	106.071		106.016	103.355				
EXISTING SURFACE	106.082		105.996	105.928				
CHAINAGE	0.000		5.897	11.4.19				

SECTION A

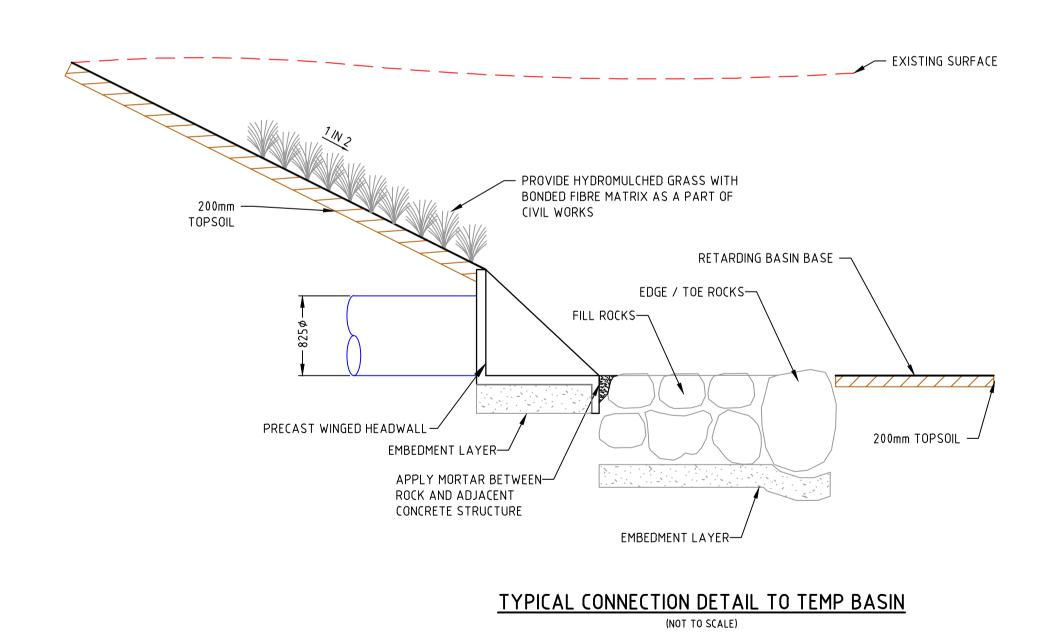

spiire.com.au


Yourland Developments spire Checked Designed P.COLLIER C.DOBRZELAK L6 414 LA TROBE STREET PO BOX 16084 MELBOURNE Date Authorised VICTORIA 8007 AUSTRALIA T 61 3 9993 7888 14/06/24 M.HOLMES ABN 55 050 029 635




any use or reliance by third party on the content of this document.



IGH CYCLONE BOUNDARY

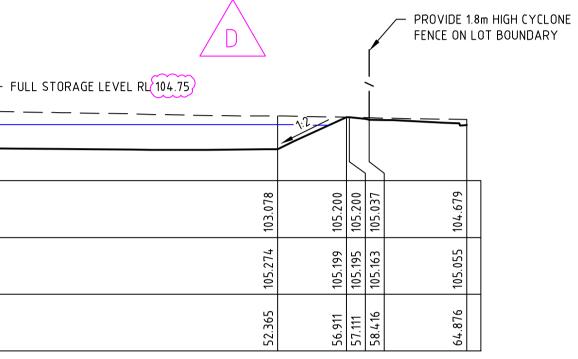

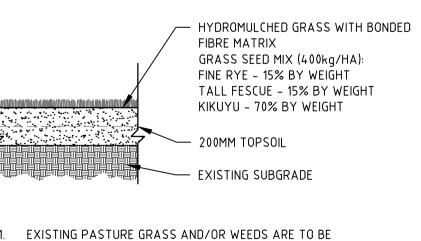

1. EXISTING PASTURE GRASS AND/OR WEEDS ARE TO BE

- SPRAYED WITH HERBICIDE. 2. NO MACHINERY TO BE USED WITHIN THE DRIP LINE OF
- EXISTING TREES. 3. TOPSOIL TO BE RAKED TO A FINE TILTH, REMOVAL OF ALL SURFACE ROCKS, LARGE LUMPS OF CLAY, WEEDS, RUBBISH PRIOR TO APPLICATION OF DRILL SEEDED GRASS TO ALL
- AREAS AS SHOWN. 4. NEW GRASSED AREAS TO BE PROTECTED FROM TRESPASS AND TRAFFIC WITH STAR PICKETS AND BARRIER ROPE UNTIL GRASS IS ESTABLISHED.

